

CERTIFIED LAND CORNER RESTORATION

Index No. 0 - 6

State of Wisconsin



County of Oneida } ss.

History of original corner establishment:
Two squared posts and a 3/4" iron pipe bears S27W 63.0' of new established monument.

I, Glen Barker, do hereby certify that on the 21st day of March, 1984, I found ~~restored~~ the NW 1/16 corner of Section 20 Township 36 North, Range 6 East, Fourth Principal Meridian, as described hereon; and that from this evidence I established a new monument and accessories as described hereon to perpetuate the original location of this corner.

Resident witnesses:

J. Clafflin, Reg. Land Surveyor
H. Wagoner

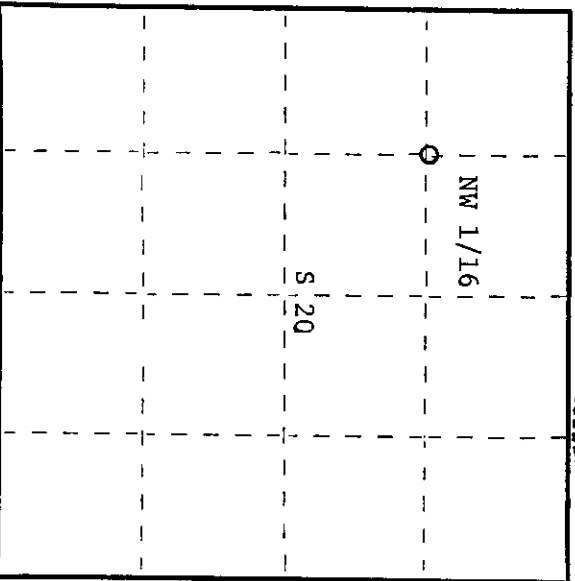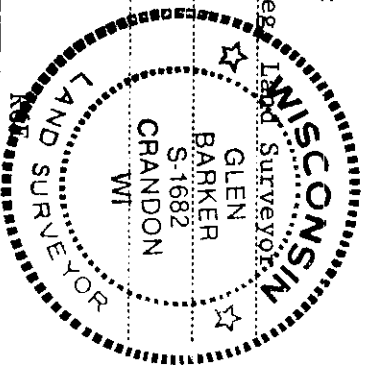

○ = Corner monument restored.

Description of corner evidence found:

Corner established by subdivision of the NW 1/4 Section 20. NW 1/16 sets 1322.25' of NC 1/16 and 1321.84' of WC 1/16.

Description of monument and accessories I established to perpetuate the original location of this corner.

Set a 1" iron pipe with 2" diameter alloy cap stamped:

Monument projects 18" above ground. S1682
Marked NBTs: T36N R6E
Black Spruce 6" N11E 27.72' NW 1/16 S + 20
Black Spruce 9" S53E 23.10' CPI 1984
scribed 1/16 B.T.

Dated at Rhineland, Wis., this 19th day of April, 1984

Signature: *Glen Barker* Title: Registered Land Surveyor Registration No. 1682
(County Surveyor, Registered Land Surveyor, or other duly authorized official)

Office of Register of Deeds, County of Oneida
Instrument was filed in this office for record on the 23rd day of May, 1984 at 1:08 o'clock P.M. I hereby certify that the within

Doris George Tucker
(Register of Deeds)

By: Deputy

2606203030