

Stock No. 26273

CERTIFIED LAND CORNER RESTORATION

State of Wisconsin }
County of Oneida } ss.

I John H. Fisher, do hereby certify that on the 12 day of July, 1983, I found evidence of the northeast corner of Section 28 Township 36 North, Range 6 East, Fourth Principal Meridian, as described hereon; and that from this evidence I established ~~permanent monument~~ accessories as described hereon to perpetuate the original location of this corner:

Description of original monument and accessories and subsequent restorations:

The original Governemnt survey was performed by Joseph H. Jinkines, Deputy Surveyor in October 1862

Table with 4 columns: Monument Type, Size, Bearing, Distance. Includes Set Wood Post, Tamarack (8", 7", 7", 6"), and bearings like S62°W, N26°W, N14°E, S48°W.


Description of corner evidence found:

Table with 4 columns: Monument Type, Size, Bearing, Distance. Includes 1" iron pipe in centerline of Prairie Rapids Road, Tamarack (11"), N8°W, 45.25 feet.

Description of monument and accessories I established to perpetuate the location of this corner:

Corner in good condition
New bearing trees

Table with 4 columns: Monument Type, Size, Bearing, Distance. Includes Nail in Tamarack (8", 13", 6") and bearings like N36°E, S56°E, S19°E.

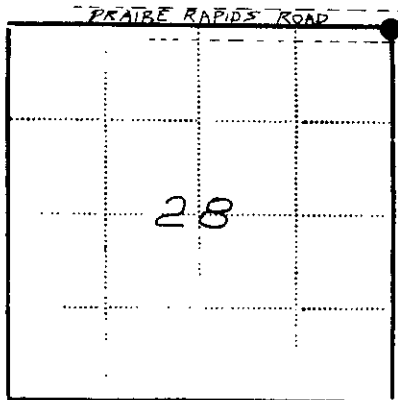

● - Corner monument restored
□ -

Resident witnesses None

Dated at Minocqua Wisconsin, this 29 day of July 1983.

Signature John H. Fisher Title Registered Land Surveyor (County Surveyor, Registered Land Surveyor, or other duly authorized official)

Surveyors Registration No.

Office of Register of Deeds County of Oneida

I hereby certify that the within instrument was filed in this office for record on the 11 day of June 1986, and was filed in Book No. Page No. of County Records.

Signature Doris Verage Kuhn Title Register of Deeds Cynthia A. Peters, Deputy

Township, Range, Section, Index No., Page No.

R-13

