


# U.S. PUBLIC LAND SURVEY MONUMENT RECORD

**Note:** This form is intended and designed to fulfill all requirements of Wisconsin Administrative Code, Chapter A-E 7.08 U.S. Public Land Survey Monument Record (3) (a) (b) (c) (d) (e) (f) (g) (h) (i). An additional sheet may be added if necessary to conform with said requirements.

(a) Corner location: Township 36 North  
 Range 7 East/West

Town/City/Village Woodboro  
 County Oneida

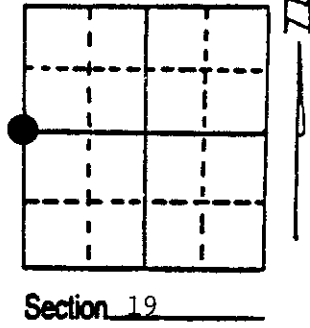


(b) (f) (g) (h) Description of monument found at this corner and if it was accepted, state all evidence (material, testimonial, occupational, plats, records, other monuments) used as a basis for accepting. If not accepted or if nothing was found, state evidence used as basis for establishing location. If reestablished through lost corner proportionate methods, indicate all monuments, distances and directions used to establish. Indicate type of monument found or set and sign post.

- 8/31/1860 - Alfred Millard established this corner and set a wood post with 2 BTs:  
 10" Spruce Pine, N21°E, 96 Links      14" Y. Pine, N42°W, 16 Links  
 (error in GLO distance recognized by Maine)
- 10/1/1937 - Maine found stumps of original BTs:  
 14" Y. Pine, N42°W, 1.65 Chains      10" Y. Pine, N21°E, .96 Chains  
 He placed a 2" x 60" iron pipe with brass cap and made 2 new BTs:  
 4" Jack Pine, S16°W, 33 Links      3½" Jack Pine, S83°W, 38 Links
- 2/26/1990 - Milo E. Stefan found Maine's monument in good condition. Both BTs of Maines very decayed stumps. I made 4 new BTs and set a plastic sign post.

(c) (d) (e) Plan view of corner with ties to at least 4 witness monuments. If in disagreement with previously established corner, show the distances between the two corners and also indicate the ties to the disputed corner.

- 1) 2" x 60" Iron pipe with brass cap
  - 2) 2" Red Oak, N65°E, 18.16'
  - 3) 2" Aspen, S10°E, 11.96'
  - 4) 3" Aspen, S82°W, 16.07'
  - 5) 3" Aspen, N23°W, 12.20'
  - 6) Plastic sign post, Northeast, .3'
- Distances to nail in side of BT.  
 BTs scribed "BT" in stump blaze.

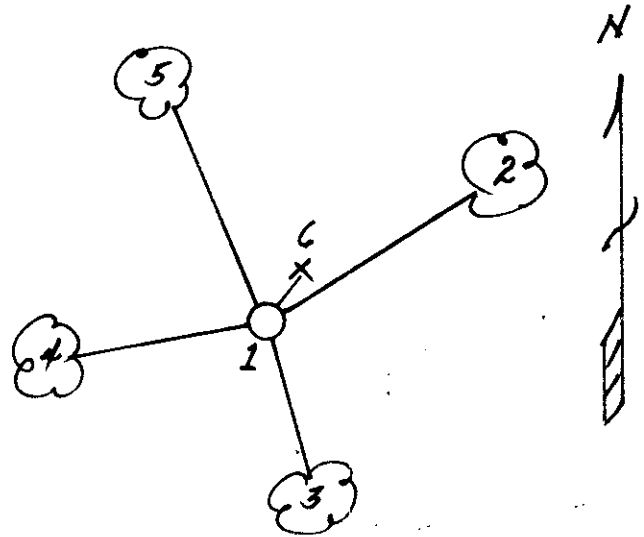

(i) I, Milo E. Stefan  
 (type or print name) certify that the corner location on this record was determined by me or under my direction and control and that this U.S. Public Land Survey Monument Record is correct and complete to the best of my knowledge and belief.

Milo E. Stefan      2/27/90  
 Signature      Date



Stamp 3606242000

Index No. P-1