

U.S. PUBLIC LAND SURVEY MONUMENT RECORD


Note: This form is intended and designed to fulfill all requirements of Wisconsin Administrative Code, Chapter A-E 7.08 U.S. Public Land Survey Monument Record (3) (a) (b) (c) (d) (e) (f) (g) (h) (i). An additional sheet may be added if necessary to conform with said requirements.

(a) Corner location: Township 36 North

Range 6 East ~~West~~

Town/City/Village NOKOMIS

County ONEIDA

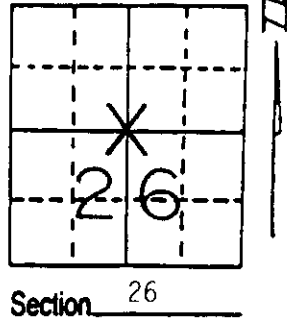

(b) (f) (g) (h) Description of monument found at this corner and if it was accepted, state all evidence (material, testimonial, occupational, plats, records, other monuments) used as a basis for accepting. If not accepted or if nothing was found, state evidence used as basis for establishing location. If reestablished through lost corner proportionate methods, indicate all monuments, distances and directions used to establish. Indicate type of monument found or set and sign post.


Plat of Frank & Theresa White's Subdivision calls for a 2" Iron Pipe set at the center of Section. Dug through 3" of Black top, 1 foot of undisturbed sand, found 2" Iron Pipe. Matched Plat distance by 0.05'. Held pipe as Center of Section, tied out, referenced to existing center line of Lake Nokomis Road.

Distances looked very good to surrounding corners.

Pounded 1 1/2" Iron Bar into top of 2" Iron Pipe, flush with Black Top. Measurements taken to center of bar.

SEE BACK FOR SECTION SUMMARY

(c) (d) (e) Plan view of corner with ties to at least 4 witness monuments. If in disagreement with previously established corner, show the distances between the two corners and also indicate the ties to the disputed corner.

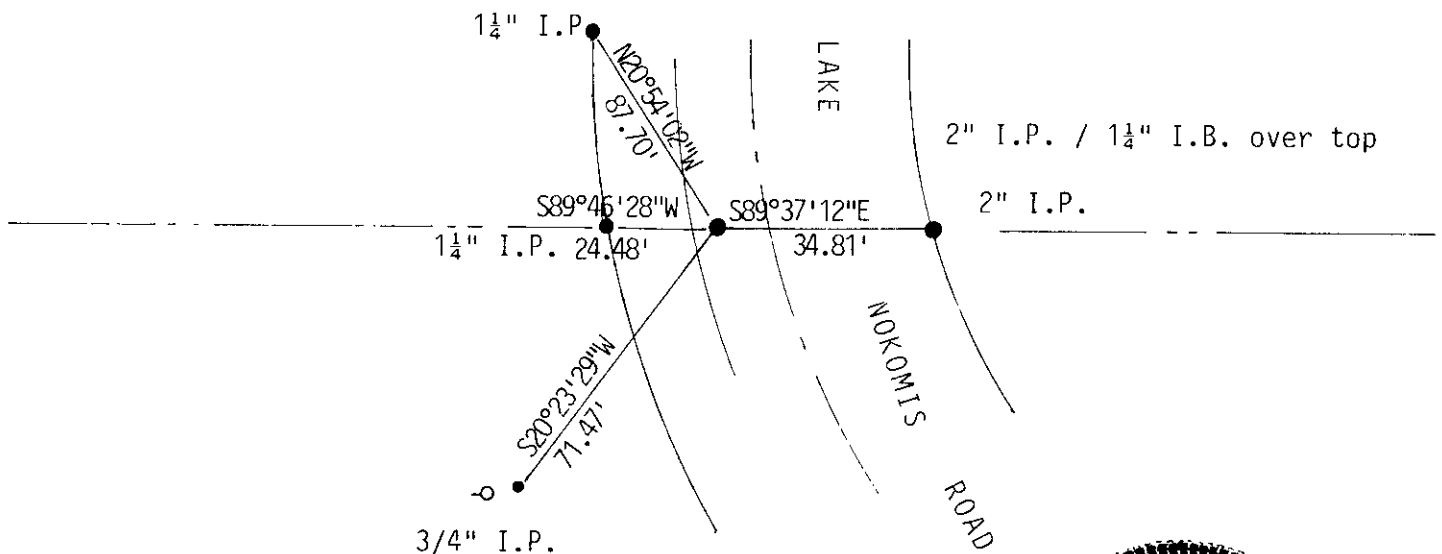

(i) I, David L. Osterbrink RLS No. S-2014
 (type or print name) certify that the corner location on this record was determined by me or under my direction and control and that this U.S. Public Land Survey Monument Record is correct and complete to the best of my knowledge and belief.

David L. Osterbrink 10-24-93
 Signature Date



Index No. T-19

Stamp 3606262020

