
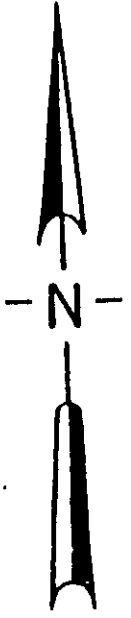


SECTION SUMMARY

27 - 36 - 6
Section - Town - Range

Nokomis
Township

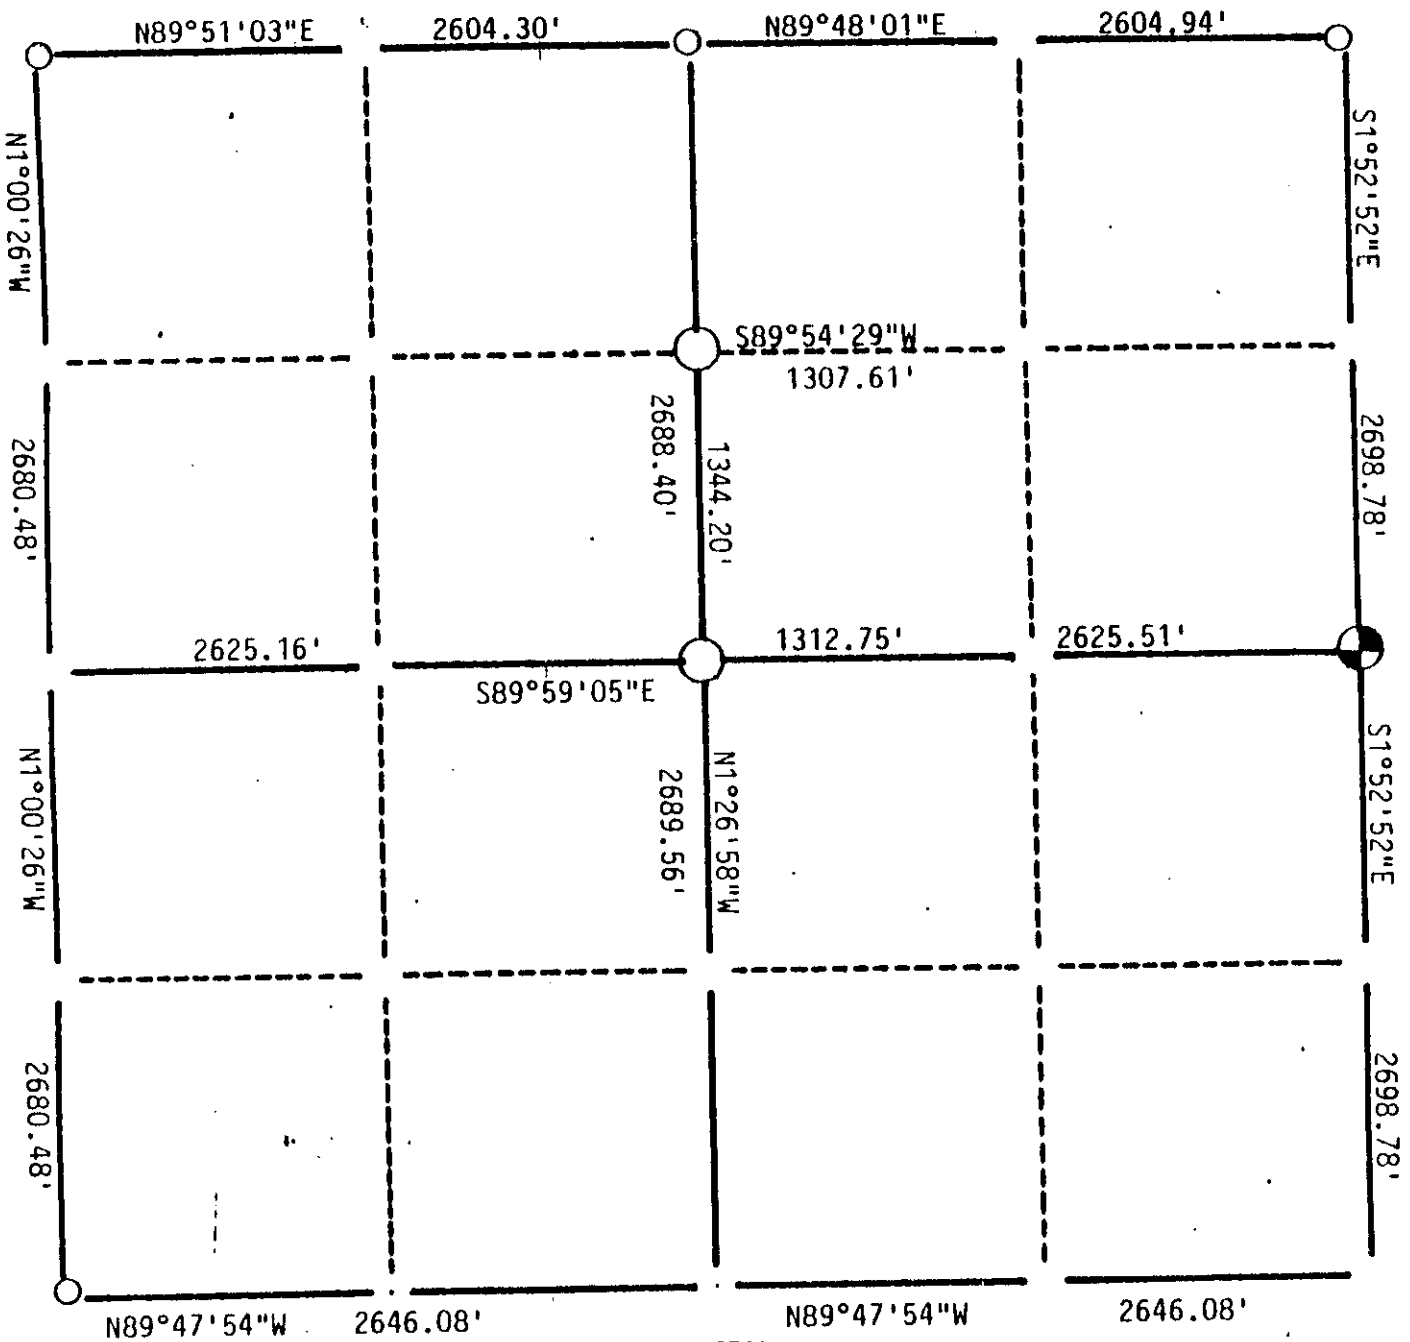

LEGEND

- ⊕ - Oneida County 2" Aluminum capped monument
- - Stone or Concrete Monument
- - 2" Iron Pipe
- - 1" Iron Pipe
- - Iron Bar
- - Other

CERTIFIED CORRECT:

David L. Osterbrink RLS No. S-2014
Registered Land Surveyor

DATE: 8-24-93

