

U.S. PUBLIC LAND SURVEY MONUMENT LOCATION RECORD

Recorders Data

CORNER: North 1/4 SECTION: 33 TOWNSHIP 36 NORTH RANGE 6 EAST/WEST

FOR M.C. CORNER INDICATE: NAME OF WATERWAY N/A SECTION LINE N/A


(CITY/VILLAGE/TOWN) OF: Nokomis COUNTY OF: Oneida

Description of monument found or placed and all other evidence used as a basis for monument location; including all monuments and related measurements required if the corner location is reestablished by lost corner proportionate methods. Also indicate name of original surveyor, survey date, corner monument set and established bearing trees, witness or reference monuments with ties from available records.

Found and accepted an old undisturbed 1 1/4" dia. iron pipe monument at this corner location with uncapped top 5" below existing blacktop pavement patch with a PK nail above center of iron pipe and bright orange circle painted around it recently by Austin for Oneida County GPS project in progress. I carefully drove a 3/4" dia. by 12" iron rod in the center of the iron pipe found, with top flush with roadway surface, and also drove 1/4" dia. by 2 1/2" long PK nails 1' North, South, East and West on cardinal right lines thru the corner center to aid future recovery and usage. In 1862, Jenkins/GLO set a wood post as the original corner and marked BTs, an 8" Pj N65°E 21 lks and an 8" Pj S32°E 22 lks, which are all now gone in roadway area. In 1970, Fisher/Northwoods Surveyors, notes monument found in center of road junction and BTs, a 5" Pj S44°W 92.5' and an 8" Pj N44°E 69.2', which I found and used for new ties, per his Plat of Survey, B-648, Oneida County records. In 1976, Schmit notes a 1 1/2" dia. iron pipe at the corner per his Plat of Survey, B-1314, Oneida County records, and also as a 1" iron pipe found with both Fisher 1970 BTs noted on record plat of Krystal Cove 1st Addition, excepting that tie to NE Fisher BT is in error by 1 foot. In 1981, J. Rein accepted this corner location iron pipe per his Plat of Survey, B-1126, Oneida County records, and also noted a 1" dia. iron rod N52°16'W 4.54' and a 1 1/4" dia. iron pipe N21°57'E 3.90' from the 1 1/4" dia. iron pipe accepted as the correct corner location; which I also confirmed by metal locator detection in roadway. By common report the 1970 location by Fisher prevails.

This recovery completed June 4, 1998; there were no witnesses other than vehicle drive-bys.

Plan view map of monument location with bearing and distance ties to a minimum of four(4) described witness or reference monuments of concrete, natural stone, iron, live bearing trees or equivalent material. If applicable, also show a minimum of two(2) bearing and distance ties to any other monument found and not accepted; including the bearing and distance from the accepted monument. Indicate the basis for bearings of reference ties if not referenced to magnetic north.

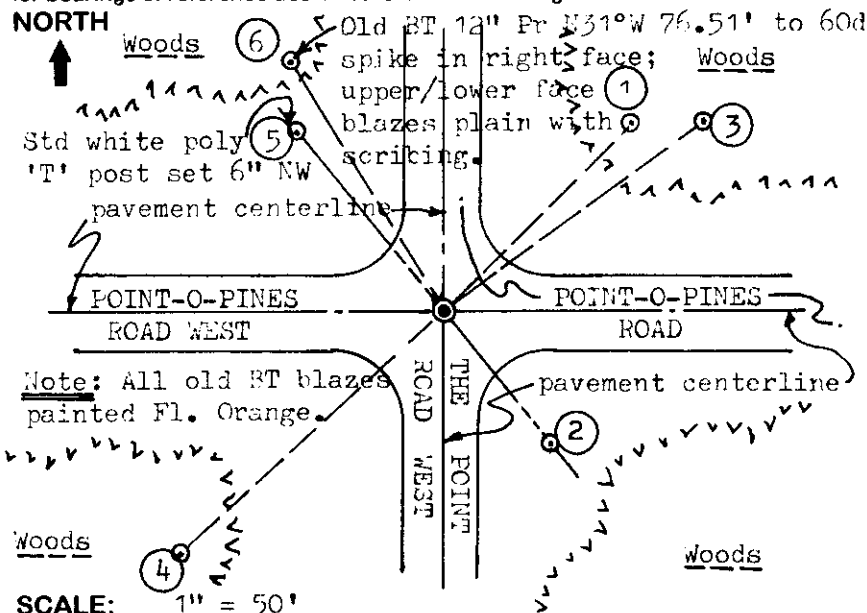

WITNESS MONUMENT TIES:

- ① Old BT dead 13" Pj N45°E 69.51' to old 60d spike in right face, upper & lower blazes plain with scribing; nailed BT sign to SW face.
- ② 1 1/4" dia. iron pipe found with top uncapped 3" above grade and red top white plastic stake nearby, S38°E 41.44'.
- ③ New BT 18" Pr N54°E 84.65'.
- ④ Old BT 8" Pj S48°W 92.63' to old 60d spike in right face; upper blaze shut but plain, lower blaze open with scribing.
- ⑤ 1" dia. by 24" long iron pipe set with Ref. Mk cap N38°W 60.53'.


SCALE: 1" = 50'

Unless otherwise indicated, all bearing tree ties are to a .25" dia. by 2.5" long PK nail with a 1.25" dia. steel washer driven into unblazed right face and a .25" dia. by 2.5" long PK nail with a 2" dia. steel washer stamped 'BT' is also driven into unblazed face of bearing tree at DBH; the basis for measured bearings is magnetic to nearest degree and all tie distances are horizontal measure to nearest 1/100th feet.

LAND SURVEYOR CERTIFICATION:

I, William C. Rohde, hereby certify that I am a duly licensed Professional Land Surveyor in Wisconsin, that this USPLS monument location was determined by me or under my direction and control, and that this U.S. Public Land Survey Monument Location Record is true and correct to the best of my knowledge and belief.

William C. Rohde Date: 6/11/98
Signature

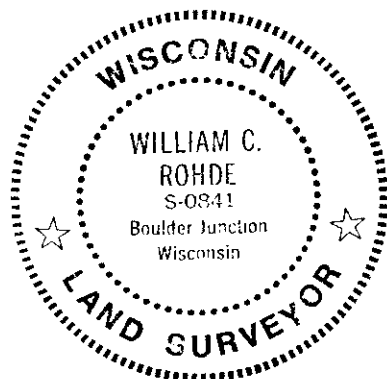

RLS SEAL

SHEET NO. 1 OF 1

	33		

SECTION LOCATION MAP

INDEX NO. V 11

3606280020

INDEX NO. V 11

This form is intended to fulfill requirements of Chapter A-E 7.08 (3)(a)(b)(c)(d)(e)(f)(g)(h)(i) U.S. Public Land Survey Monument Location Record, Wisconsin Administrative Code. Use reverse side for geodetic location data and/or continuation purposes.