

CERTIFIED LAND CORNER RESTORATION

Index No. T-8

State of Wisconsin } ss.
County of Oneida }

History of original corner establishment:
a 4" squared cedar post N15-09-01E 0.68' of new position.


I Glen Barker, do hereby certify that on the 6th day of March 19 84, I ~~renewed~~ established ~~renewed~~ the EC 1/16 corner of Section 29 Township 36 North, Range 6 East, Fourth Principal Meridian, as described hereon; and that from this evidence I established a new monument and accessories as described hereon to perpetuate the original location of this corner.

Description of corner evidence found:
Total distance from C1/4 Section 29 to 1/4 corner positioned in Tomahawk River is 2576.75'. Distance determined using C1/4 to M.C. on west shore - being the east-west quarter line to a 1/4 corner position determined by Running from section corner 20-21-28-29 to S 1/16 between 28 and 29 for alignment on distance.

Resident witnesses:


J. Claflin - R.L.S.

H. Wagoner

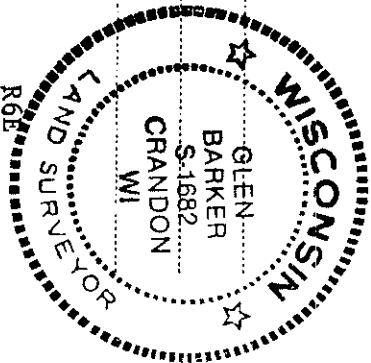

Description of monument and accessories I established to perpetuate the original location of this corner.

- Set a 1"x24" iron pipe for EC 1/16
- Bearing trees to I.P.
- Red pine 16" N8°W 18.44'
- Scribed 18 ft.
- Jack pine 4" N66E 43.96'
- Scribed 1/16

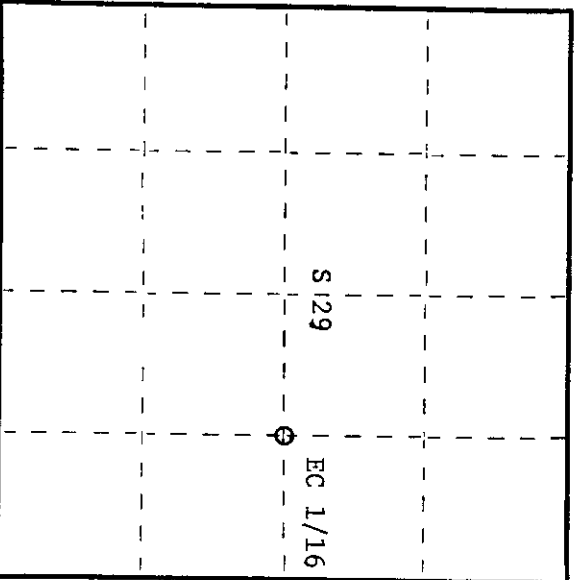

○ = Corner monument restored.

Dated at Rhinelander, Wis., this 19th day of April, 19 84

Signature: *Glen Barker* Title: Registered Land Surveyor Registration No. 1682
(County Surveyor, Registered Land Surveyor, or other duly authorized official)

Office of Register of Deeds, County of Oneida
Instrument was filed in this office for record on the 23rd day of May, 1984 at 1:08 o'clock P.M. I hereby certify that the within

Signature: *Dorrie Teenage Kuehn*
(Register of Deeds)

By: Deputy

3606292010