

State of Wisconsin } ss.
County of Oneida }

CERTIFIED LAND CORNER RESTORATION



Index No. 7-6

History of original corner establishment:
No evidence of any previous corner.

I, Glen Barker, do hereby certify that on the 27th day of February, 1984, I established the corner of Section 29, Township 36 North, Range 6 East, Fourth Principal Meridian, as described hereon; and that from this evidence I established a new monument and accessories as described hereon to perpetuate the original location of this corner.

Resident witnesses:

J. Clafflin, Reg. Land Surveyor
H. Wagoner

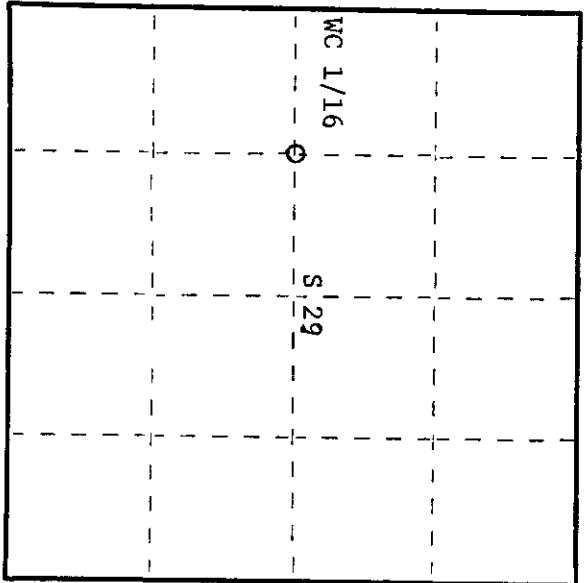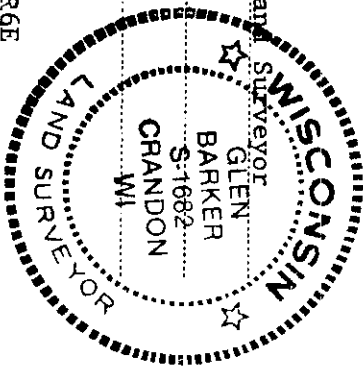

○ = Corner monument restored.

Description of corner evidence found:

Total distance from 1/4 corner between sections 29 and 30 to C 1/4 section 29 is 2659.89'.
Set WC 1/16 1329.945' intermediate.

Description of monument and accessories I established to perpetuate the original location of this corner.

Set a 1" iron pipe with 2" diameter alloy cap stamped:
Monument projects 12" above ground.
Marked NBTs:
White Pine 15" S58E 16.13'
Red Pine 22" N34E 38.25'
scribed 1/16 - B.T.

S1682
T36N R6E
WC 1/16 S 29
CPI - 1984

Dated at Rhinelander, Wis., this 19th day of April, 1984

Signature: *Glen Barker* Title: Registered Land Surveyor Registration No. 1682
(County Surveyor, Registered Land Surveyor, or other duly authorized official)

Office of Register of Deeds, County of Oneida
Instrument was filed in this office for record on the 23rd day of May, 1984
at 11:08 o'clock M.

Doris Verage Fuchs
(Register of Deed)

By: _____ Deputy

3606292020