

State of Wisconsin }
County of Oneida } ss.


CERTIFIED LAND CORNER RESTORATION

Index No. S-6

I Glen Barker do hereby certify that on the 24th day of February, 1984, I found ~~established~~ the NW 1/16 corner of Section 29 Township 36 North, Range 6 East, Fourth Principal Meridian, as described hereon; and that from this evidence I established a new monument and accessories as described hereon to perpetuate the original location of this corner.

Resident witnesses:

J. Clafflin, Reg. Land Surveyor
H. Wagoner

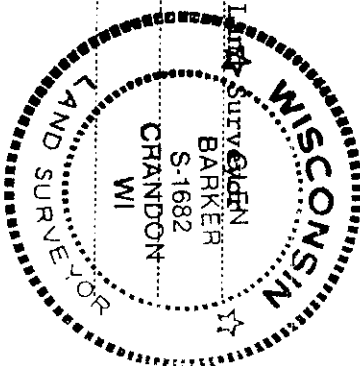

History of original corner establishment:
No evidence of any previous corner.


Description of corner evidence found:

Corner established by subdivision of the NW 1/4 section 29. NW 1/16 sets 1333.54' of WC 1/16 and 1333.41' of NC 1/16.

Description of monument and accessories I established to perpetuate the original location of this corner.

Set a 1" iron pipe with 2" diameter alloy cap stamped:
Monument projects 18" above ground.

Marked NBTs:
Jack Pine 3" S30E 12.48' S1682
Jack Pine 4" S70W 28.27' T36N R6E
scribed 1/16-B.T. NW 1/16 S 29
CPI - 1984

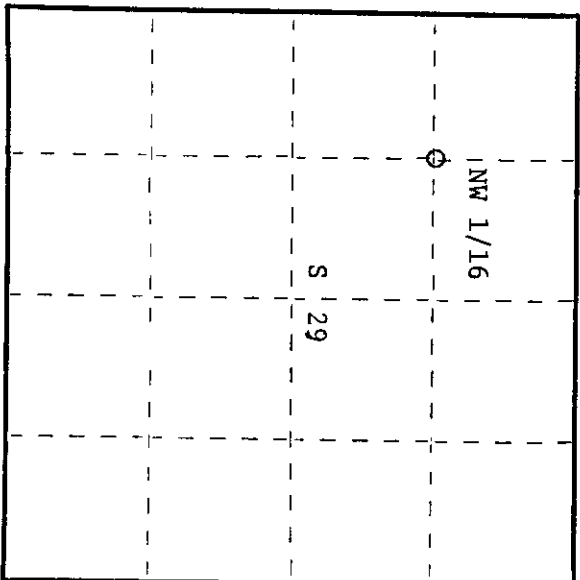

○ = Corner monument restored.

Dated at Rhinelander, Wis., this 19th day of April, 1984.
Signature: *Glen Barker* Title: Registered Land Surveyor Registration No. 1682
(County Surveyor, Registered Land Surveyor or other duly authorized official)

Office of Register of Deeds, County of Oneida
Instrument was filed in this office for record on the 24th day of February, 1984, at 11:00 o'clock.
I hereby certify that the within instrument was filed in this office for record on the 24th day of February, 1984.

Doree Leverage Fuchs
(Register of Deeds)

By: Deputy

3606293030