

CERTIFIED LAND CORNER RESTORATION

U. S. Public Land Survey Monument Record  
History of original corner establishment:

The original Government Survey was performed by Joseph H. Jenkins,  
Deputy Surveyor in October, 1862.  
Wood Post Set:

Yellow Pine	20"	S40°W	121 links
Yellow Pine	20"	N48°W	160 links
Yellow Pine	18"	S28°E	112 links

Description of corner evidence found:

Nail in County Trunk Highway "Y" N9°E, 22 feet from Owens Illinois post,  
marked corner N9°E, 22 feet.  
(Get Dip with metal locator)


Nail in Norway Pine	9"	N14°W	64.70 feet
Nail in Norway Pine	10"	N29°W	50.05 feet
Nail in Norway Pine	11"	N56°W	60.14 feet
Nail in Jack Pine	7"	S53°W	41.33 feet

Description of monument and accessories I established to perpetuate the original location of this corner.  
I established a 1-1/4" iron pipe over nail found in place and established  
new bearing trees:

Resident witnesses:  
None

State of Wisconsin } ss.  
County of Oneida }

I John H. Fisher, do hereby  
certify that on the 23 day  
of June, 1983, I found  
evidence of the Northeast  
corner of Section 31  
Township 36 North, Range  
6 East, Fourth Principal Meridian,  
as described hereon; and that from this evidence  
I established a new monument and accessories  
as described hereon to perpetuate the original  
location of this corner.

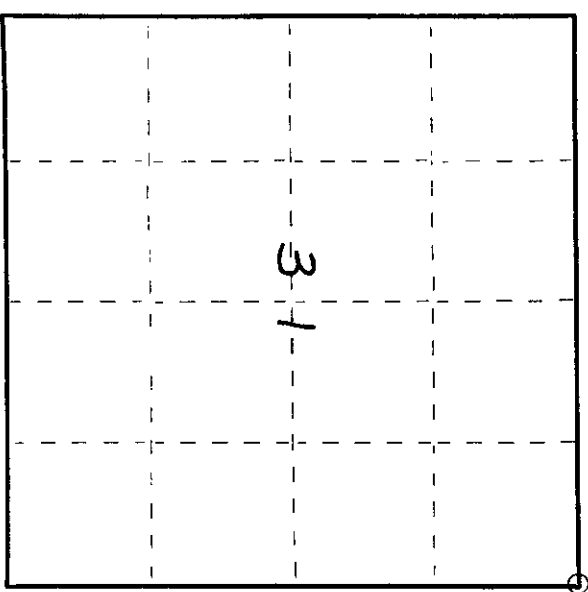

○ = Corner monument restored.

Dated at Minocqua, Wis., this 4th day of October, 1983.

Signature: *Richard H. Hill* Title: Registered Land Surveyor Registration No. S-836  
(County Surveyor, Registered Land Surveyor, or other duly authorized official)

Office of Register of Deeds, County of Oneida, 18th day of January, 1984.  
at 10:00 o'clock A.M.

Signature: *Louis George Kuehn*  
(Register of Deeds)

By: Deputy Oneida County Surveyor date *Robert J. ... 18 JAN 84*

Compared with all record data and accepted as correct.



(c) Describe any material discrepancy between the location of the corner as restored or reestablished and the location of that corner as previously restored or reestablished by distance and direction. Show the discrepancy on the plan view drawing under (d), above. Show the distances between the corner as previously restored or reestablished and (1) the corner as restored or reestablished, and (2) to at least 2 of the witness monuments shown on the drawing in (d), above.

See drawing below

(f) Was the corner restored through acceptance of (1) an obliterated evidence location, or, (2) a found perpetuated location?

Found perpetuated location

(g&h) Was the corner reestablished through lost corner proportionate methods? If so, show the method, including the directions and distances to other public land survey corners used as evidence or used for proportioning in determining the corner location?

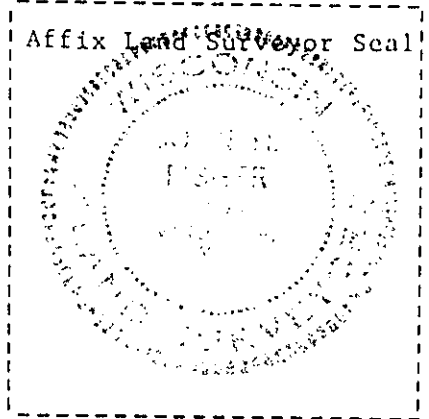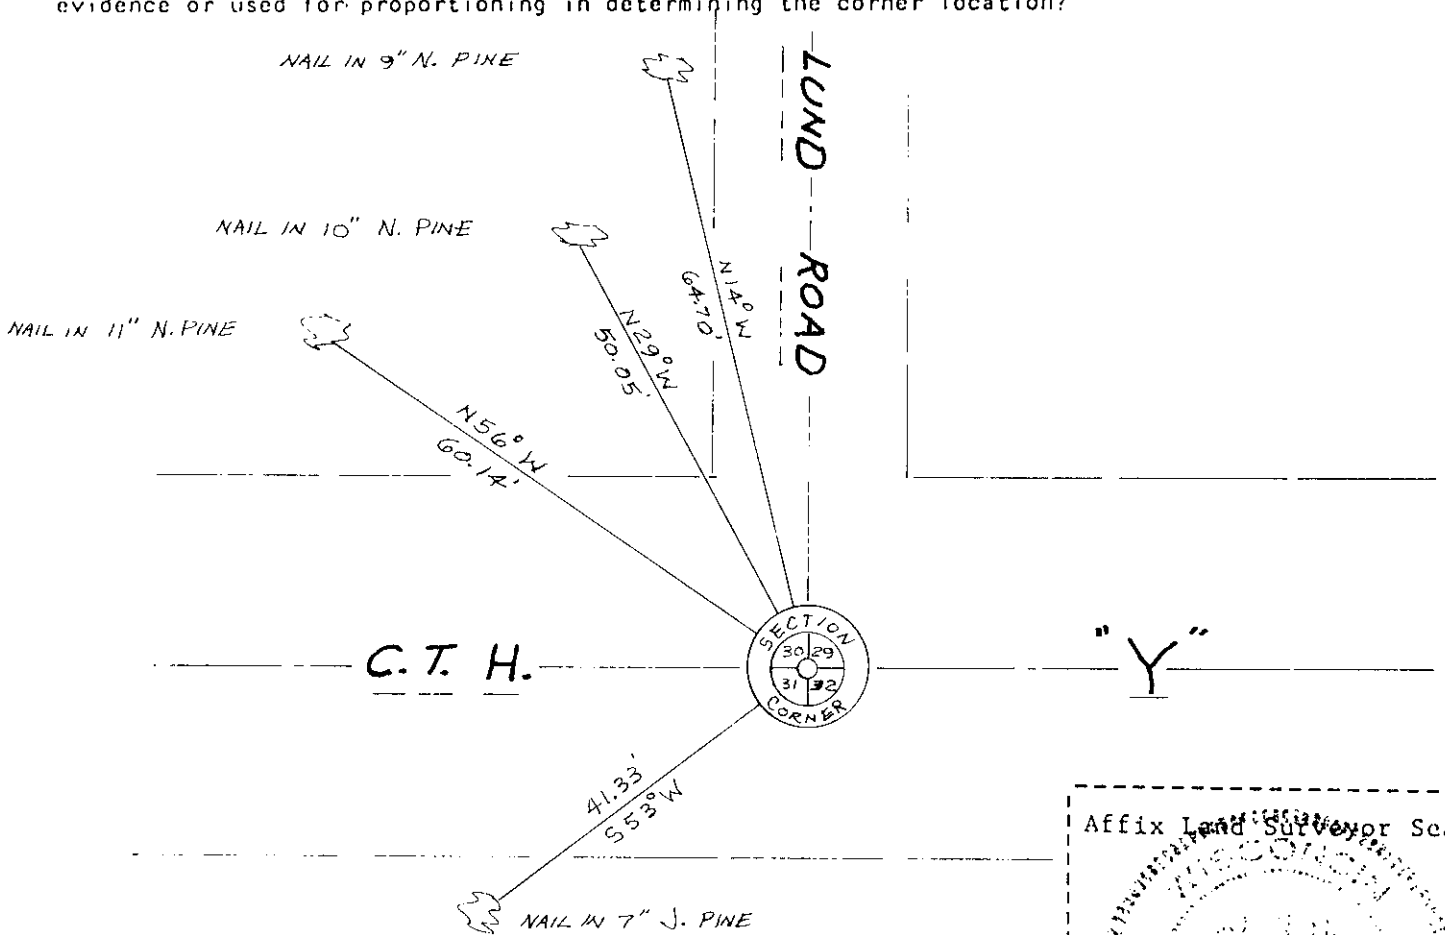

(i) I, John H. Fisher (type or print name) certify that the corner location shown on this record was determined by me or under my direction and control and that this U.S. Public Land Survey Monument Record is correct and complete to the best of my knowledge and belief.

John H. Fisher  
Signature

10/14/83  
Date

# U.S. PUBLIC LAND SURVEY MONUMENT RECORD

Note: This form is intended and designed to fulfill all requirements of Wisconsin Administrative Code, Chapter A-E 7.08 U.S. Public Land Survey Monument Record (3) (a) (b) (c) (d) (e) (f) (g) (h) (i). An additional sheet may be added if necessary to conform with said requirements.


(a) Corner location: Township 36 North

Range 6 East/West

Town/City/Village NOKOMIS

County ONEIDA

COR 20  
4360630000

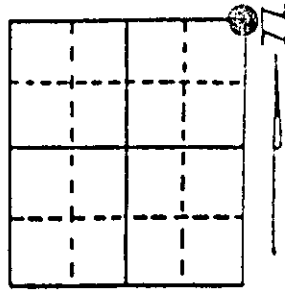

Section 31


(b) (f) (g) (h) Description of monument found at this corner and if it was accepted, state all evidence (material, testimonial, occupational, plats, records, other monuments) used as a basis for accepting. If not accepted or if nothing was found, state evidence used as basis for establishing location. If reestablished through lost corner proportionate methods, indicate all monuments, distances and directions used to establish. Indicate type of monument found or set and sign post.

FOUND 1 1/4" DIA. IRON PIPE, SET BY JOHN H. FISHER IN 1983

BT<sup>S</sup> FOUND

- NAIL IN 10" R. PINE, N14°W, 64.70 FT.
- NAIL IN 11" R. PINE, N29°W, 50.05 FT.
- NAIL IN 12" R. PINE, N56°W, 60.14 FT.

(c) (d) (e) Plan view of corner with ties to at least 4 witness monuments. If in disagreement with previously established corner, show the distances between the two corners and also indicate the ties to the disputed corner.

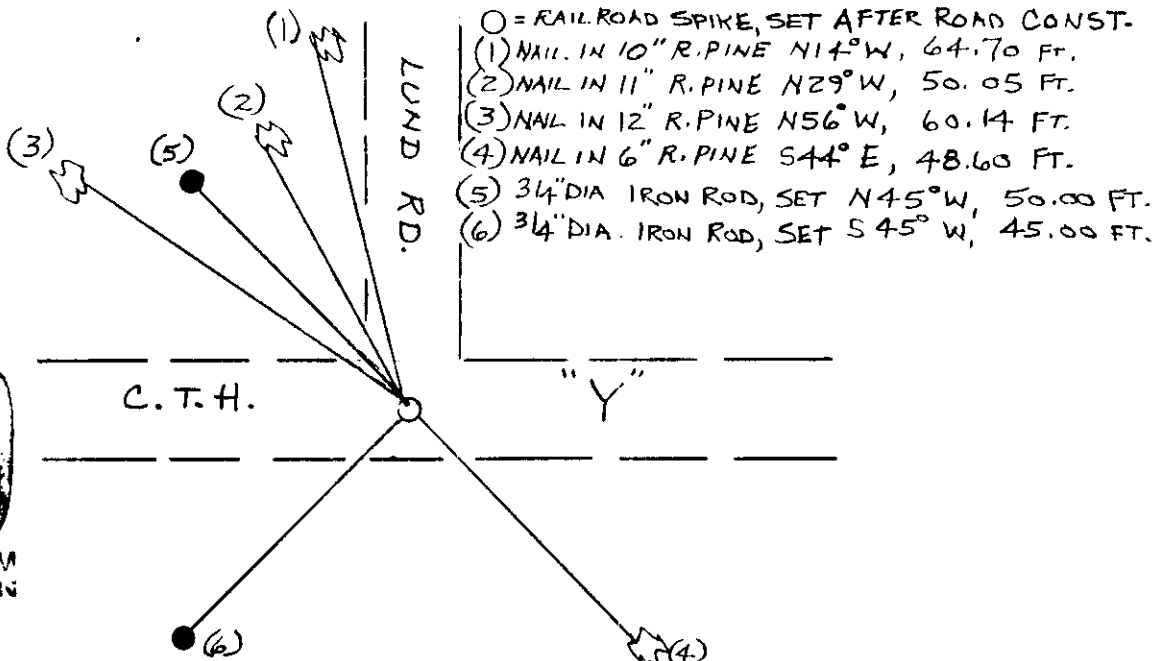

REGISTER OF DEEDS OFFICE  
ONEIDA COUNTY, WIS.  
FEB 16 1998  
O'Clock  
THOMAS H. LEIGHTON  
REGISTER OF DEEDS

(i) I, DENNIS B. ROBERTS

(type or print name) certify that the corner location on this record was determined by me or under my direction and control and that this U.S. Public Land Survey Monument Record is correct and complete to the best of my knowledge and belief.

Dennis B. Roberts 12-03-97  
Signature Date




Index No. Y 5

Stamp 360630000

**U.S. PUBLIC LAND SURVEY MONUMENT RECORD**

Note: This form is intended and designed to fulfill all requirements of Wisconsin Administrative Code, Chapter A-E 7.08 U.S. Public Land Survey Monument Record (3) (a) (b) (c) (d) (e) (f) (g) (h) (i). An additional sheet may be added if necessary to conform with said requirements.

(a) CORNER LOCATION: WISCORS - Oneida County  
 Cor. of Secs. 29, 30, 31 & 32 N: 140,097.15 USft  
 Township 36 North E: 170,720.49 USft  
 Range 6 East of the 4th P.M. Datum: NAD 1983(2011)  
 Town of Nokomis County of Oneida

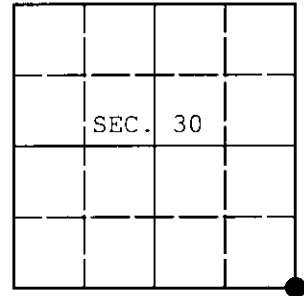

(b) HISTORY OF ORIGINAL CORNER ESTABLISHMENT

Original Surveyor: \_\_\_\_\_ Original Accessories: \_\_\_\_\_  
 Date of Survey: Commenced: \_\_\_\_\_  
 Completed: \_\_\_\_\_



(b) (f) (g) (h) Description of monument found at this corner and if it was accepted, state all evidence (material, testimonial, occupational, plats, records, other monuments) used as a basis for accepting. If not accepted or if nothing was found, state evidence used as basis for establishing location. If re-established through lost corner proportionate methods, indicate all monuments, distances and directions used to establish. Indicate type of monument and sign post found or set.

*This is a perpetuation of a previous USPLS Monument Record by Dennis B. Roberts, RLS dated December 3, 1997 and filed in the office of the Oneida County Register of Deeds. A complete history of the corner can be found on the previous monument record. I accept the previous location as a true and faithful perpetuation or reestablishment of the original corner location and further perpetuate it as follows.*

June 27, 2013: Prior to road construction, I found and accepted the record monument, a railroad spike 3 ft. South of the centerline of County Highway Y. I performed a GPS observation referenced to the WISCORS GNSS Network. I found or established accessories as shown below.

August 8, 2015: Following road construction, I returned and set a cotton picker spindle at the corner point from the reference monuments established previously. I performed a second GPS observation referenced to the WISCORS GNSS Network. The coordinates shown are the mean of the two observations that differed by 0.02 ft.

(c) (d) (e) Plan view of corner with ties to at least 4 witness monuments. If in disagreement with previously established corner, show the distances between the two corners and also indicate the ties to the disputed.

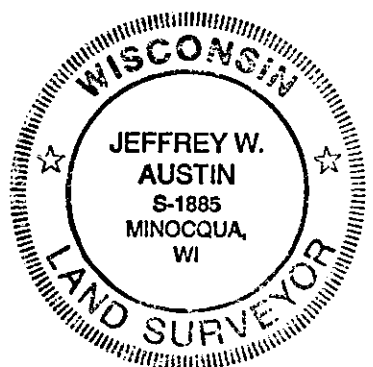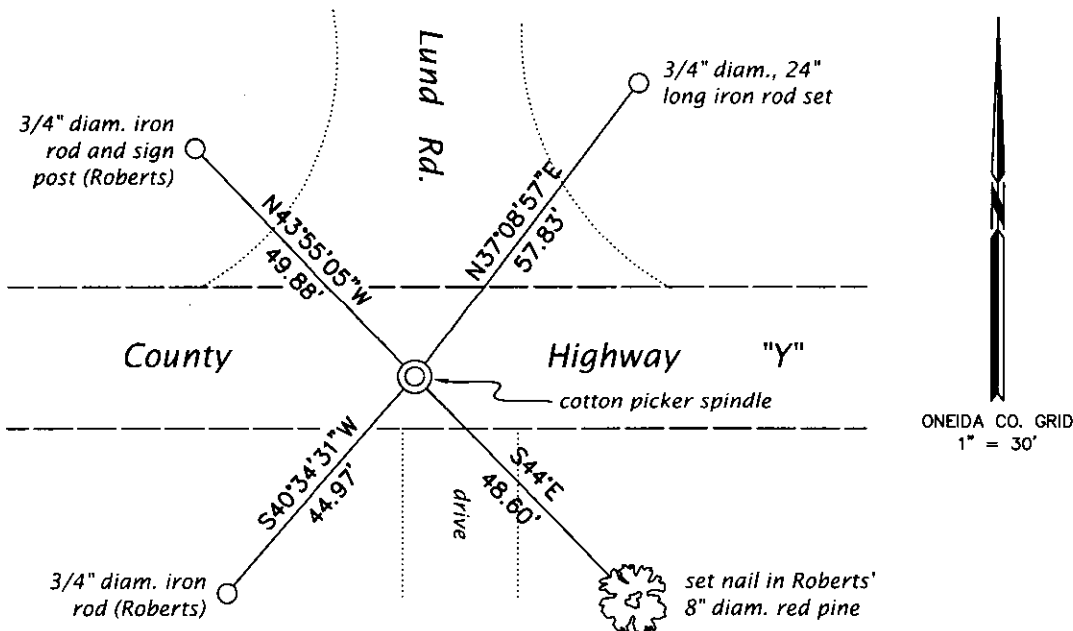


REGISTER OF DEEDS OFFICE  
 ONEIDA COUNTY  
 FILED

OCT 15 2015

AT \_\_\_\_\_ O'CLOCK \_\_\_\_\_ M  
 KYLE J. FRANSON  
 REGISTER OF DEEDS

(i) I, Jeffrey W. Austin, Professional Land Surveyor No. S-1885, hereby certify that the corner location on this record was determined by me or under my direction and control and that this U.S. Public Land Survey Monument Record is correct and complete to the best of my knowledge and belief.

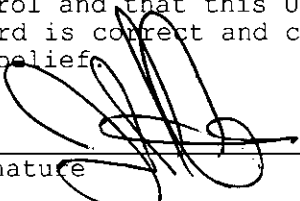Signature:  Date: Oct. 11, 2015