

CERTIFIED LAND CORNER RESTORATION

Index No. U - 2

State of Wisconsin } ss.
County of Oneida


History of original corner establishment:
No evidence of any previous corner.

I Glen Barker, do hereby
certify that on the 21st day
of December, 1983, I ~~restored~~ Estab.
~~restored~~ the SW 1/16
corner of Section 30
Township 36 North, Range
6 East, Fourth Principal Meridian,
as described hereon; and that from this evidence
I established a new monument and accessories
as described hereon to perpetuate the original
location of this corner.

Description of corner evidence found:
Corner established by subdivision of the SW 1/4.
SW 1/16 sets 1320.69' of WC 1/16 and 1324.90' of SC 1/16.

Resident witnesses:

J. Claflin - RLS
H. Wagoner

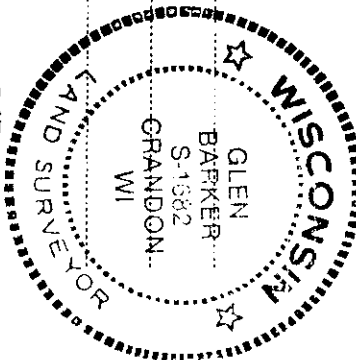


T36N

R6E

Description of monument and accessories I established to perpetuate the original location of this corner.
Set a 3/4" iron pipe with 2" diameter alloy cap stamped: S1682
Monument projects 18" above ground. T36N R6E
Marked NBTs

Red pine 7" N48W 20.18' SW 1/16 S 30
Red pine 7" N16E 8.79' CPI - 1983
Scribed 1/16 - B.T.

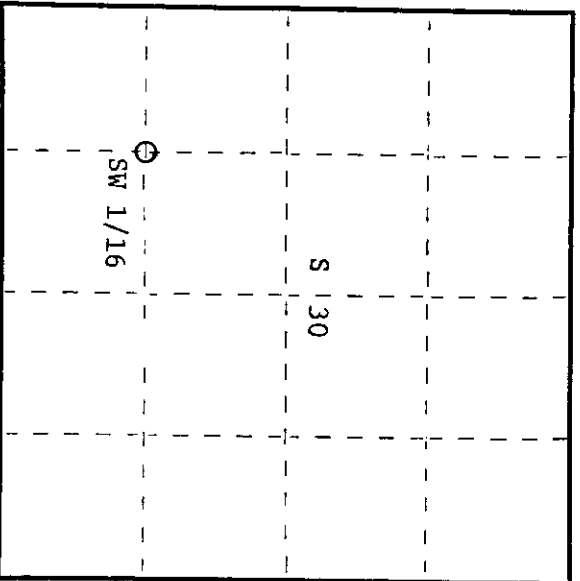

○ = Corner monument restored.

Dated at Rhinelander, Wis., this 13th day of February, 1984.

Signature: *Glen Barker* Title: Registered Land Surveyor Registration No. S1682
(County Surveyor, Registered Land Surveyor, or other duly authorized official)

Office of Register of Deeds, County of Oneida, I hereby certify that the within
instrument was filed in this office for record on the 23rd day of May, 1984
at 1:00 o'clock P.M.

Doris George Kuehn
(Register of Deeds)

By: Deputy

3606 3010 30