
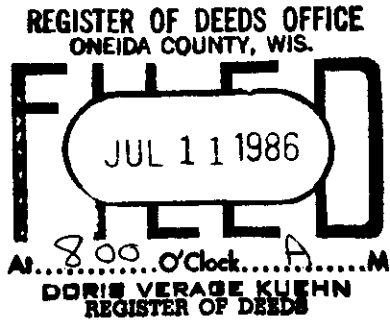


U. S. PUBLIC LAND SURVEY MONUMENT RECORD

INSTRUCTIONS: This record shall show the location of the corner and shall include all of the following nine elements (a through i).

- (a) Identify the corner by reference to the U.S. public land survey system.
 ● = Corner monument restored.


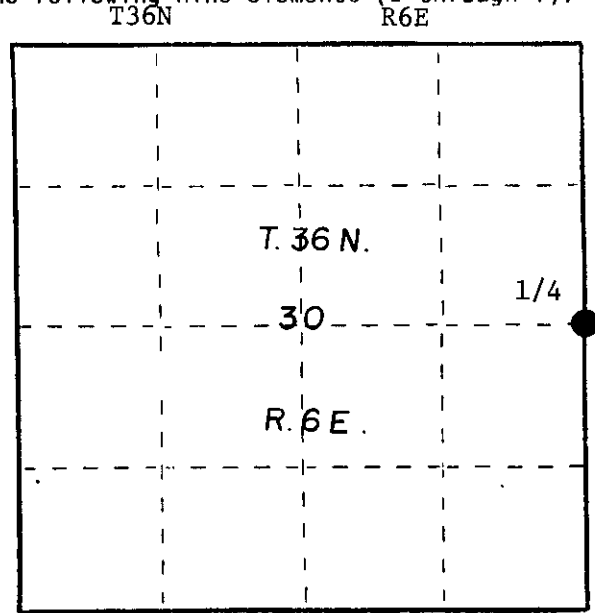


- (b) Describe any record evidence, monument evidence, occupational evidence, testimonial evidence or any other material evidence you considered, and whether the monument was found or placed.

Re-established quarter section corner on proportionate measurement. Total distance from section corner 29-30-31-32 to section corner 19-20-29-30 is 5322.76 ft. Set quarter section corner on line and 2661.38' of either corner.

- (c) In the plan view drawing below, provide reference ties to at least 4 witness monuments, or, if the location is within a municipality, to at least 2 witness monuments. (Witness monuments shall be made of concrete, natural stone, iron or other equally durable material.) Describe witness monuments.

- (d) Show a plan view drawing depicting the relevant monuments and reference ties which is sufficient in detail to enable accurate relocation of the corner monument if the corner monument is disturbed. Indicate north.

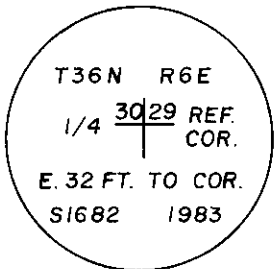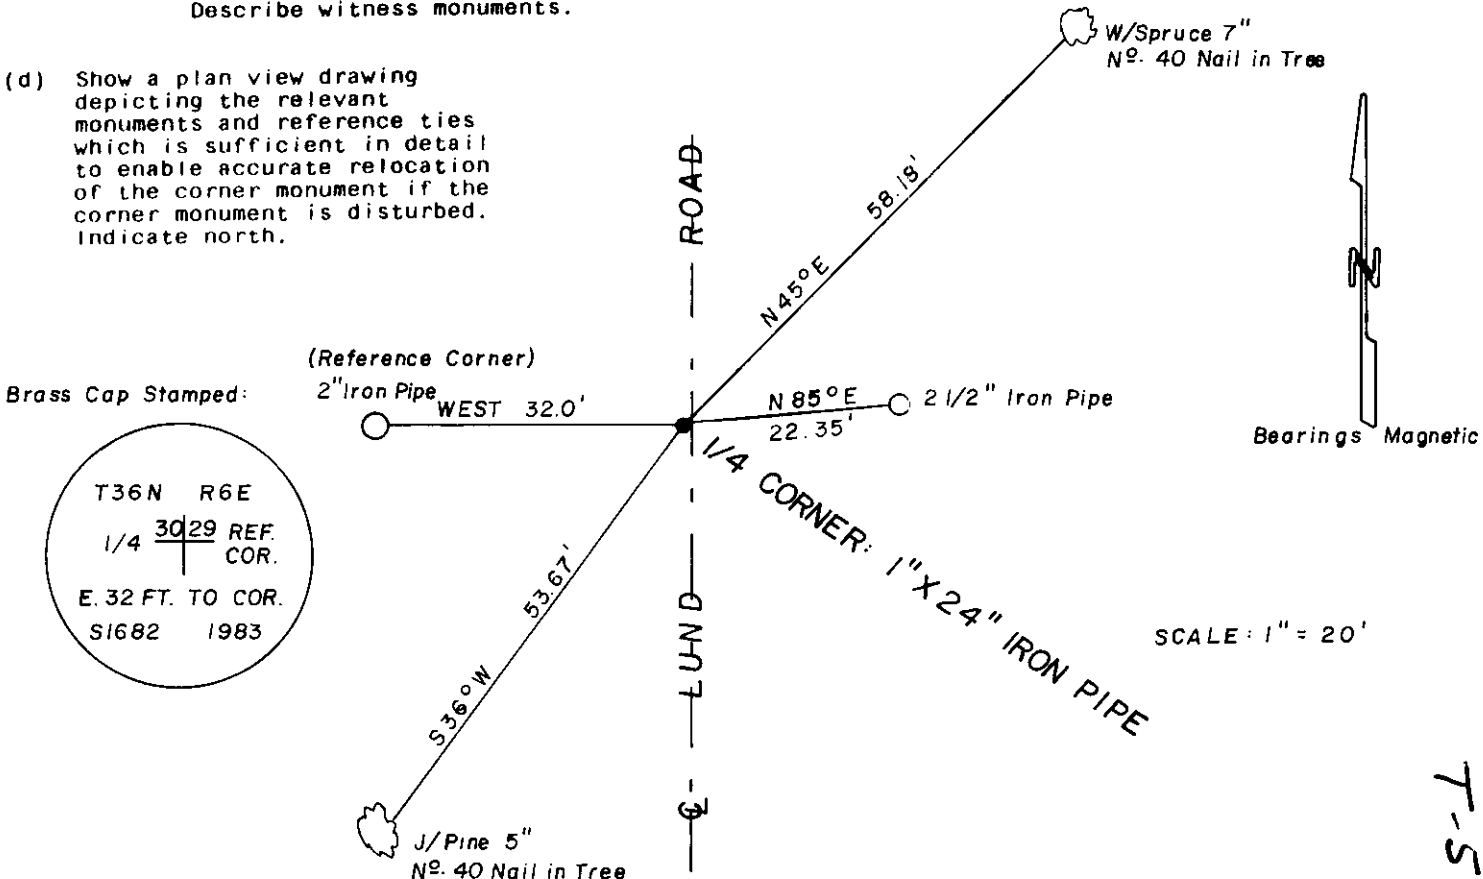

SCALE: 1" = 20'

T-5



(e) Describe any material discrepancy between the location of the corner as restored or reestablished and the location of that corner as previously restored or reestablished by distance and direction. Show the discrepancy on the plan view drawing under (d), above. Show the distances between the corner as previously restored or reestablished and (1) the corner as restored or reestablished, and (2) to at least 2 of the witness monuments shown on the drawing in (d), above.

See drawing below

(f) Was the corner restored through acceptance of (1) an obliterated evidence location, or, (2) a found perpetuated location?

(g&h) Was the corner reestablished through lost corner proportionate methods? If so, show the method, including the directions and distances to other public land survey corners used as evidence or used for proportioning in determining the corner location?

Corner re-established by proportionate method.

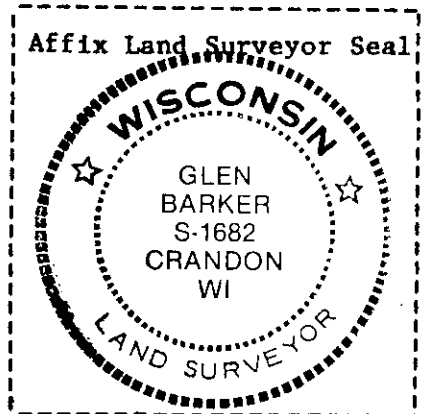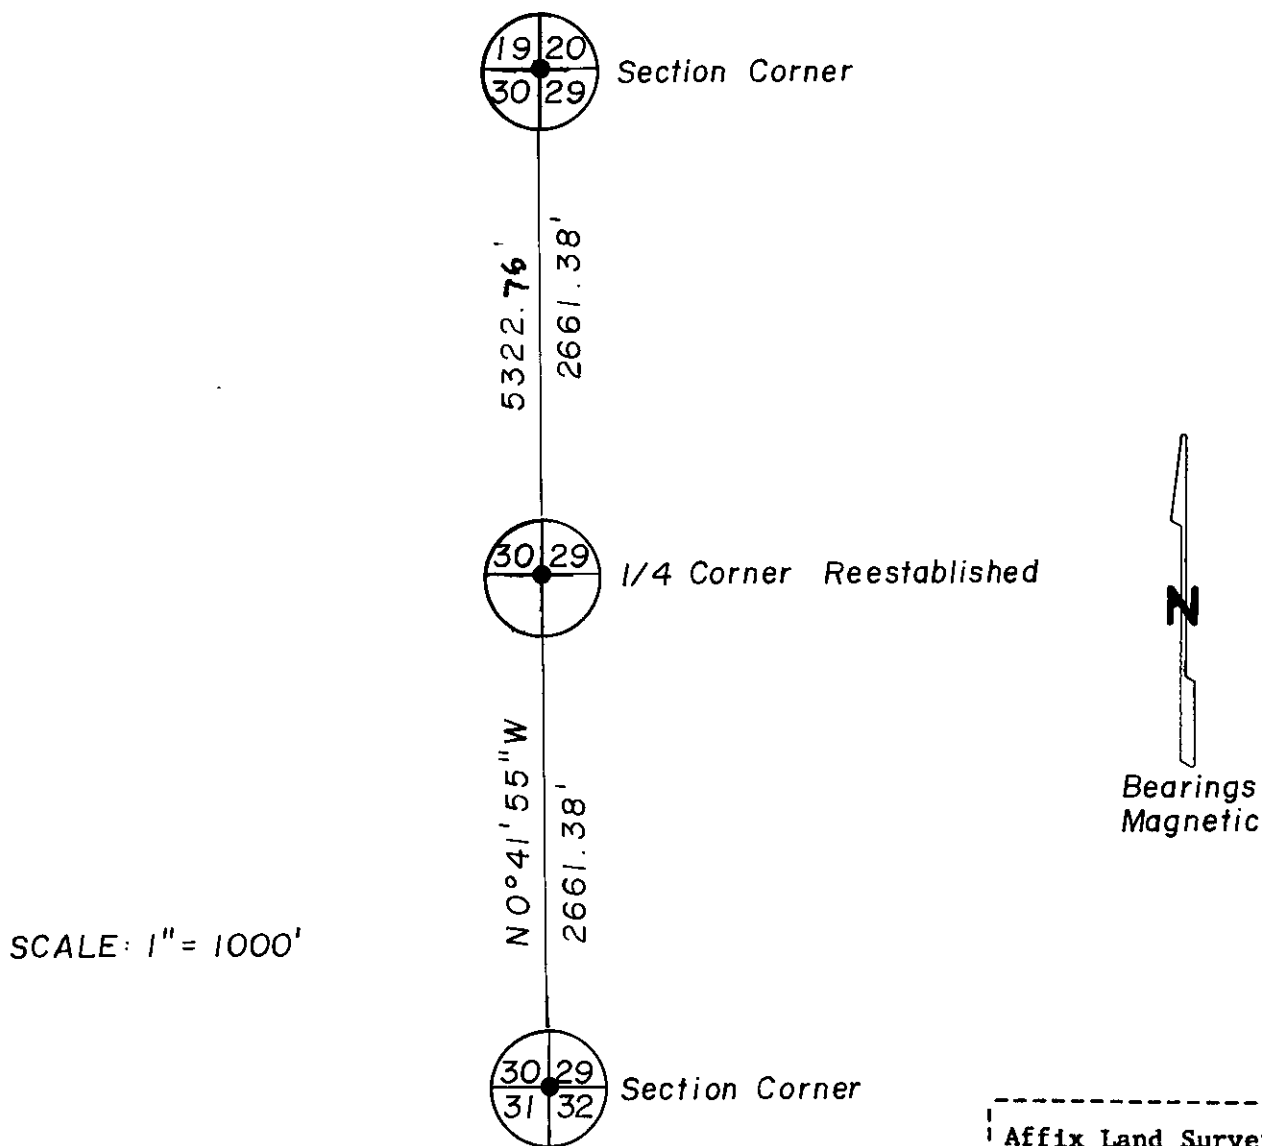

(i) I, Glen Barker
 (type or print name) certify that the corner location shown on this record was determined by me or under my direction and control and that this U.S. Public Land Survey Monument Record is correct and complete to the best of my knowledge and belief.

Signature

Glen Barker

Date

2/14/84

U.S. PUBLIC LAND SURVEY MONUMENT RECORD

This form is intended and designed to fulfill all requirements of Wisconsin Administrative Code, Chapter A-E 7.08 U.S. Public Land Survey Monument Record (3) (a)(b)(c)(d)(e)(f)(g)(h)(i). An additional sheet may be added if necessary to confirm with said requirements.

REGISTER OF DEEDS OFFICE
ONEIDA COUNTY
FILED


AUG 28 2023

KYLE J. FRANSON
REGISTER OF DEEDS

(a) Corner Location:

E 1/4 Corner Section 30
Township 36 North
Range 6 East
Town of Nokomis
County of Oneida

Corner ID: 3606302000

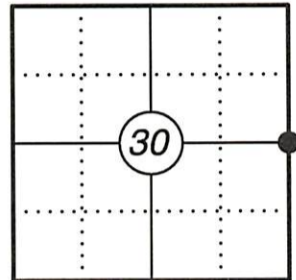

(b) History of Original Corner:


Original Surveyor: Joseph H. Jenkins Original B.T.'s: Blk Pine 10 S55°E 21 links
Date of Survey: Oct. 1862 Blk Pine 10 S40°W 52 links

(f)(g)(h) Description of monument found at this corner and if it was accepted, state all evidence (material, testimonial, occupational, plats, records, other monuments) used as a basis for establishing location. If reestablishing through lost corner proportionate methods, indicate all monuments, distances, and directions used to establish. Indicate type of monument and sign post found or set.

For corner history, see previous U.S. Public Land Survey Monument Record by Glen Barker dated 2/14/1984 who set corner by proportionate method.

04/26/2023 - I did not find the iron pipe in the road set by Barker at the corner. I set a 1 1/4" iron pipe in the road from the published county coordinates which checked well with Barker's two remaining witnesses, a 2" reference pipe west of corner and his 7" Spruce N45°E which is now a stump. I witnessed the corner as shown below.

(c)(d)(e) Plan view of corner with ties to at least four witnesses. If in disagreement with previously established corner, show the distances between the two corners and also indicate the tie to the disputed corner.

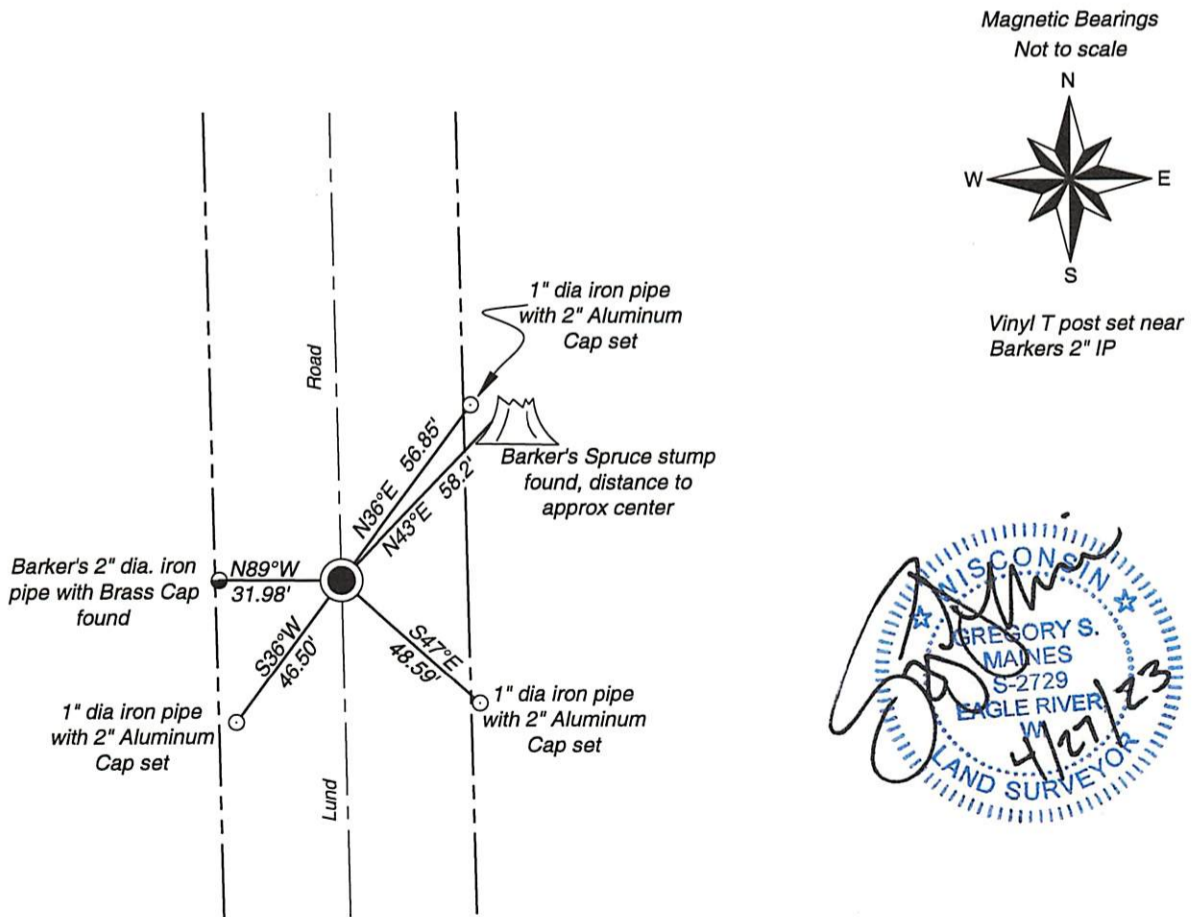

Magnetic Bearings
Not to scale



Vinyl T post set near
Barker's 2" IP



Certification

I, Gregory S. Maines, Professional Land Surveyor No. 2729, hereby certify that the corner location on this record was referenced by me or under my direction and control and that this U.S. Public Land Survey Monument Record is complete to the best of my knowledge and belief.
REF: 2022055

Index No.: T-5