

CERTIFIED LAND CORNER RESTORATION



Index No. T-4

State of Wisconsin } ss.
County of Oneida }

History of original corner establishment:
No evidence of any previous corner.

I Glen Barker do hereby
certify that on the 16th day
of December 19 83, I ~~Restored~~ Estab.
~~restored~~ the EC 1/16
corner of Section 30
Township 36 North, Range
6 East, Fourth Principal Meridian,
I established a new monument and accessories
as described hereon to perpetuate the original
location of this corner.

Resident witnesses.
J. Claflin - RLS
H. Wagoner

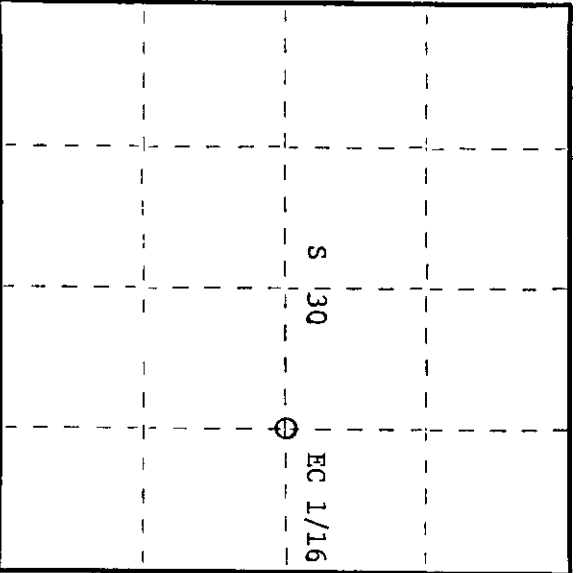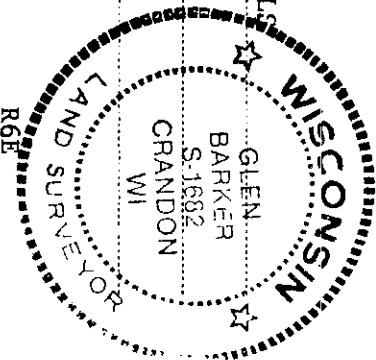

○ = Corner monument restored.

3606302010

Description of corner evidence found:

Total distance from 1/4 between Sections 29 & 30 to C 1/4 Section 30 is 2638.89'.
Set EC 1/16 1319.45' intermediate.

Description of monument and accessories I established to perpetuate the original location of this corner.

Set a 1" iron pipe with 2" diameter alloy cap stamped: S1682

Monument projects 18" above ground. T36N R6E

Marked NPTs: Jack pine 4" N74W 12.26' EC 1/16 S 30

Jack pine 5" S56E 14.53' CPI - 1983

Scribed 1/16 - B.T.

Dated at Rhineland, Wis., this 13th day of February, 19 84

Signature: *Glen Barker* Title: Registered Land Surveyor Registration No. S1682
(County Surveyor, Registered Land Surveyor or other duly authorized official)

Office of Register of Deeds, County of Oneida, I hereby certify that the within
instrument was filed in this office for record on the 23rd day of May, 19 84
at 4:00 o'clock P.M.

Doris George Kuehn
(Register of Deeds)

By: Deputy