

CERTIFIED LAND CORNER RESTORATION

Index No. T-2

State of Wisconsin } ss.
 County of Oneida }



History of original corner establishment:
 No evidence of any previous corner

I Glen Barker do hereby
 certify that on the 14th day
 of December 19 83 I have
~~restored~~ ^{restored} the WC 1/16
 corner of Section 30
 Township 36 North, Range
 6 East, Fourth Principal Meridian,

as described hereon; and that from this evidence
 I established a new monument and accessories
 as described hereon to perpetuate the original
 location of this corner.

Resident witnesses:

J. Claflin - RLS
 H. Wagoner

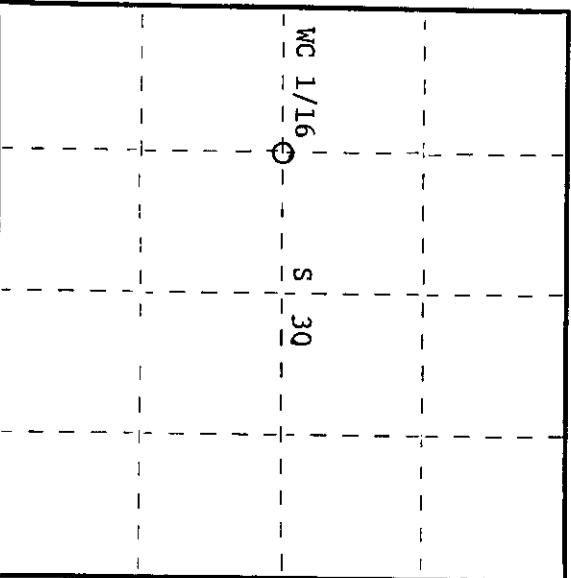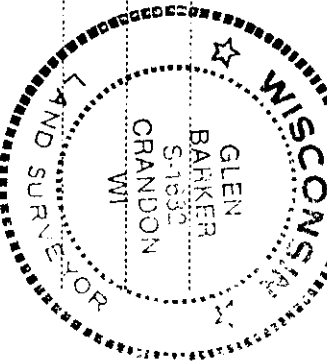

Description of corner evidence found:

Total distance from 1/4 corner between sections 25 & 30, T36N R5&6E to C 1/4 section 30 is 2415.42'.
 Set WC 1/16 1095.98' of 1/4 corner and 1319.44' of C 1/4 on a straight line between the two.

Description of monument and accessories I established to perpetuate the original location of this corner.

Set a 3/4" iron pipe with 2" diameter alloy cap stamped: S1682
 Monument projects 18" above ground. T36N R6E
 Marked NBTs; WC 1/16 S 30
 Black ash 6" N46E 9.05'
 Black ash 5" N51W 7.38'
 Scribed 1/16 - B.T. CPI - 1983

Dated at Rhineland, Wis., this 13th day of February, 19 84

Signature: *Glen Barker* Title: Registered Land Surveyor Registration No. S1682
 (County Surveyor, Registered Land Surveyor, or other duly authorized official)
 Office of Register of Deeds, County of Oneida, at 11:00 o'clock a.m. on the 23rd day of May, 1984
 I hereby certify that the within instrument was filed in this office for record on the 23rd day of May, 1984

Donna Verage
 (Register of Deeds)

By: Deputy

0302030930