

CERTIFIED LAND CORNER RESTORATION

Index No. S-5

State of Wisconsin } ss.
County of Oneida



History of original corner establishment:
Someones 1 1/2" iron pipe sets on right of way edge of Lund Road bears N88E 22.07 ft. of new position.

I Glen Barker do hereby certify that on the 2nd day of December, 1983, I found Estab. ~~corner of the~~ N 1/16 corner of Sections 29 & 30 Township 36 East, Fourth Principal Meridian,

as described hereon; and that from this evidence I established a new monument and accessories as described hereon to perpetuate the original location of this corner.

Resident witnesses:

J. Claflin - RI
H. Wagoner

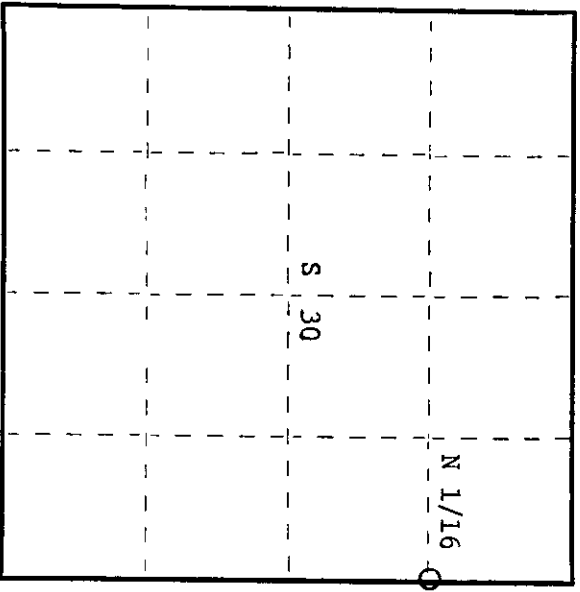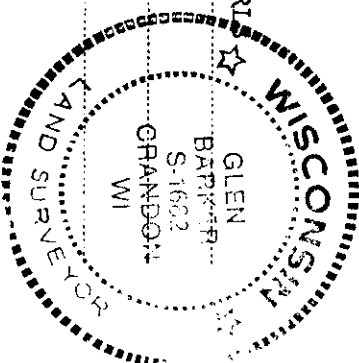

○ = Corner monument restored.

Description of corner evidence found:

Total distance from section corner 19-20-29-30 to 1/4 corner between 29 & 30 is 2661.38'
Set N 1/16 1330.69' intermediate.

Description of monument and accessories I established to perpetuate the original location of this corner.

Set a 1"x24" iron pipe in Lund Road for N1/16 6" below surface.
Set a 1" (O.D.) Iron pipe with alloy cap 33.0 west of true corner for reference monument. Alloy cap stamped:

Marked NBT to true corner: N 1/16 30 29 REF Cor.
Red pine 6" S43W 49.30' E. 33 Ft.
B.O. - 1 1/2" iron pipe N88E 22.07' S1682 - 1983

Dated at Rhinelander, Wis., this 13th day of February, 1984

Signature: *Glen Barker* Title: Registered Land Surveyor Registration No. S1682
(County Surveyor, Registered Land Surveyor, or other duly authorized official)
Office of Register of Deeds, County of Oneida
Instrument was filed in this office for record on the 23rd day of May, 1984 at 11:00 o'clock A.M.

Doris Savage Kuehn
(Registrar of Deeds)

By: Deputy

3606303000