

CERTIFIED LAND CORNER RESTORATION



Index No. S - 3

State of Wisconsin } ss.
County of Oneida }

History of original corner establishment:
No evidence of any previous corner.

I Glen Barker, do hereby certify that on the 5th day of December, 1983, I ~~restored~~ ~~re-established~~ ~~re-established~~ the NC 1/16 corner of Section 30, Township 36 North, Range 6 East, Fourth Principal Meridian, as described hereon; and that from this evidence I established a new monument and accessories as described hereon to perpetuate the original location of this corner.

Resident witnesses:
J. Claflin - RLS
H. Wagoner

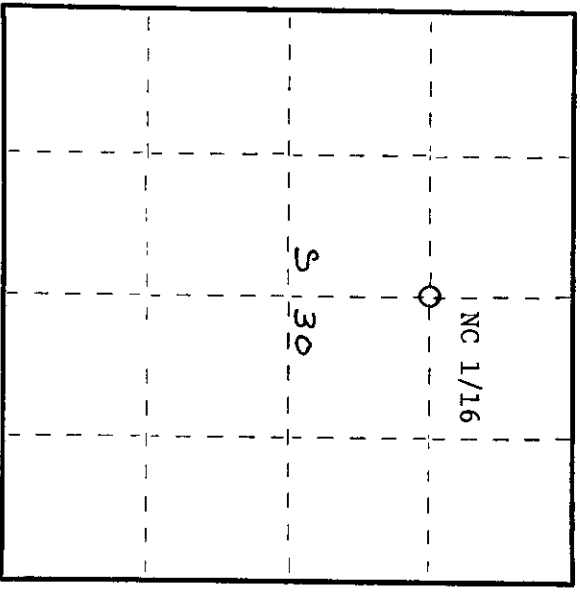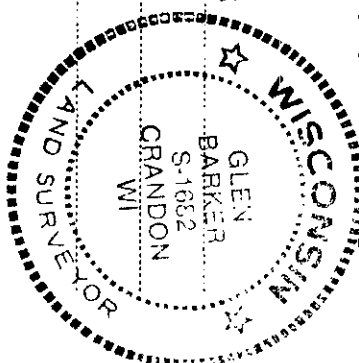

Description of corner evidence found:
Total distance from 1/4 corner between Sections 19 & 30 to C1/4 Section 30 is 2644.52'.
Set NC 1/16 1322.26' intermediate.

Description of monument and accessories I established to perpetuate the original location of this corner.
Set a 1" (O.D.) iron pipe with 2" diameter alloy cap stamped: S1682
Monument projects 18" above ground T36N R6E
Marked NBTs:
Jack pine 6" N48E 8.54' NC 1/16 S 30
Jack pine 6" S28E 7.59'
Scribed 1/16 - B.T. CPI - 1983

Dated at Rhinelanders, Wis., this 13th day of February, 1984.
Signature: *Glen Barker* Title: Registered Land Surveyor Registration No. S1682
(County Surveyor, Registered Land Surveyor, or other duly authorized official)

Office of Register of Deeds, County of Oneida, I hereby certify that the within instrument was filed in this office for record on the 25th day of May, 1984 at 1:00 o'clock P.M.
Doris Neugebauer
(Register of Deeds)

By: Deputy

3606303030