


U.S. PUBLIC LAND SURVEY MONUMENT RECORD

Note: This form is intended and designed to fulfill all requirements of Wisconsin Administrative Code, Chapter A-E 7.08 U.S. Public Land Survey Monument Record (3) (a) (b) (c) (d) (e) (f) (g) (h) (i). An additional sheet may be added if necessary to conform with said requirements.

(a) Corner location: Township 36 North
 Range 6E East/West

Town/City/Village Nokomis

County Oneida

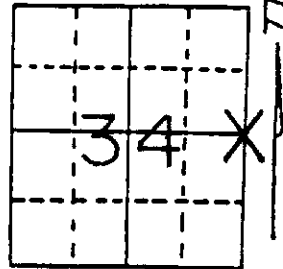

Section 34

(b) (f) (g) (h) Description of monument found at this corner and if it was accepted, state all evidence (material, testimonial, occupational, plats, records, other monuments) used as a basis for accepting. If not accepted or if nothing was found, state evidence used as basis for establishing location. If reestablished through lost corner proportionate methods, indicate all monuments, distances and directions used to establish. Indicate type of monument found or set and sign post.

Certified Survey Map Vol. 2, Pg. 380 and Bearskin Trail Survey Maps are tied to this corner. F.R. Wincentzen, Deputy County Surveyor, set this corner in 1948. His notes say that he found White Pine stump Bearing Tree, by D.H. Vaughan.

Tied into C.S.M. 2-380, and Bearskin Trail control. Distances did not match each other, or existing monument. Looked for bearing trees, but corner is in residential area, and most trees are gone. Monument looked undisturbed. Traversed to Iron Pipe that Wincentzen set North, 1000.3' found Iron Pipe, distance was off by 2.4' over hilly ground. Held monument as correct. Tied out.

Corner is 2" Iron Pipe, 20" above ground, Brass Cap. Set Oneida County warning sign by monument, painted monument yellow.

See back for drawing of Brass Cap


(c) (d) (e) Plan view of corner with ties to at least 4 witness monuments. If in disagreement with previously established corner, show the distances between the two corners and also indicate the ties to the disputed corner.

Set 3/4" Iron Bar at base of cluster 5-5" Maple

Set 3/4" Iron Bar by sign, Fire # 2039

Existing 2" I.P. Brass cap painted yellow, White witness post set next to corner.

Existing 1" Iron Pipe by Red Steel Fence Post

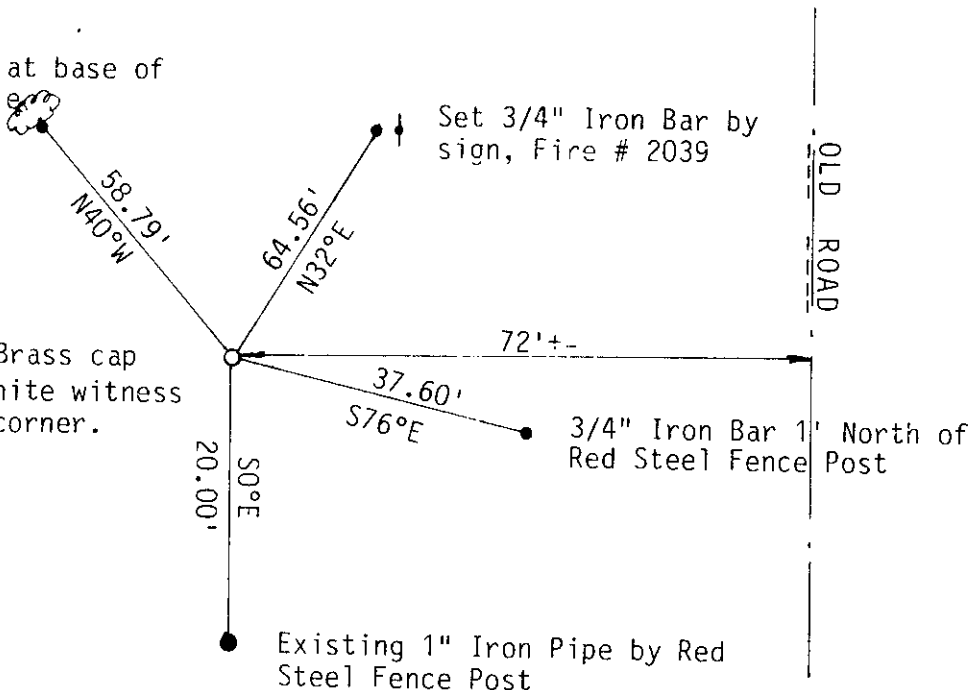

(i) I, David L. Osterbrink RLS No. S-2014

(type or print name) certify that the corner location on this record was determined by me or under my direction and control and that this U.S. Public Land Survey Monument Record is correct and complete to the best of my knowledge and belief.

David L. Osterbrink
 Signature

8-25-93
 Date



Index No. X-17

Stamp 3606 34 2000