U.S. PUBLIC LAND SURVEY MONUMENT RECORD

Note: This form is intended and designed to fulfill all requirements of Wisconsin Administrative Code, Chapter A-E 7.08 U.S. Public Land Survey Monument Record (3) (a) (b) (c) (d) (e) (f) (g) (h) (i). An additional sheet may be added if necessary to conform with said requirements.

(a) Corner location: Township 36 North

Range 7 East/~~West~~

Town/~~City~~/~~Village~~ Woodboro

County Oneida

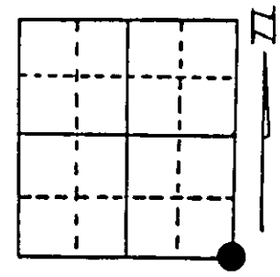

Section 1

(b) (f) (g) (h) Description of monument found at this corner and if it was accepted, state all evidence (material, testimonial, occupational, plats, records, other monuments) used as a basis for accepting. If not accepted or if nothing was found, state evidence used as basis for establishing location. If reestablished through lost corner proportionate methods, indicate all monuments, distances and directions used to establish. Indicate type of monument found or set and sign post.

9/2/1860 - Alfred Millard established this corner at 80.00 chains and set a wood post with four BTs:
10" Tamarack, N73°E, 15 Links
12" W. Pine, S16°E, 25 Links
12" Tamarack, S35°W, 10 Links
10" Tamarack, N62°W, 15 Links

7/16/1937 -Maine restored this corner from the W. Pine BT, S16°E, 25 Links. He made no new BTs.

2/6/1991 - Milo E. Stefan found monument as set by Maine in good condition. Old fence lines run north, south and east. Old 1 1/4" iron pipe along side Maine's monument. I accept this monument as the perpetuated position of the original corner position and restore same.

(c) (d) (e) Plan view of corner with ties to at least 4 witness monuments. If in disagreement with previously established corner, show the distances between the two corners and also indicate the ties to the disputed corner.

1) 2" x 60" galv. iron pipe/brass cap
2) 20" White Spruce, N44°E, 15.47 feet
3) 6" White Spruce, N82°E, 25.20 feet
4) 14" White Spruce, S65°W, 43.94 feet
5) 8" Tamarack, N73°W, 47.32 feet
6) Plastic sign post, next to monument

Distances to nail in side of BTs
BT stump blaze scribed "BT"

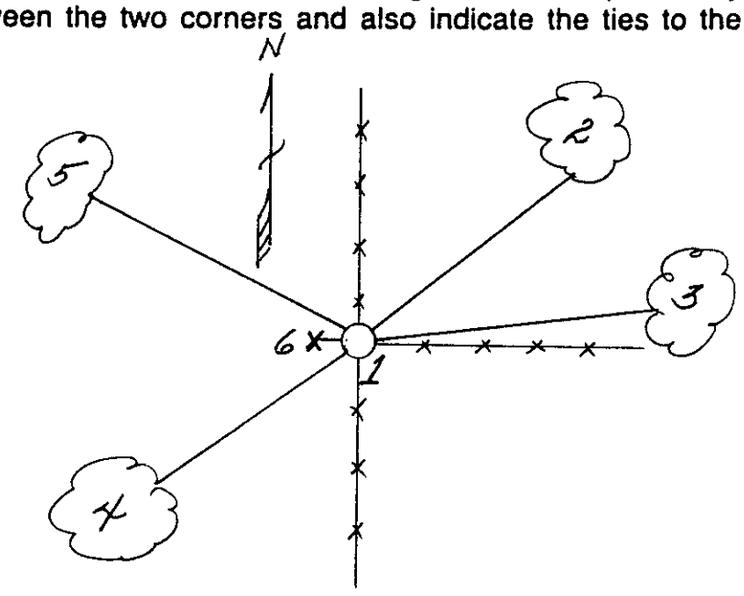

REGISTER OF DEEDS OFFICE
ONEIDA COUNTY, WIS.
FILED
APR 8 1991
At _____ O'Clock _____ M
THOMAS H. LEIGHTON
REGISTER OF DEEDS

(i) I, Milo E. Stefan (type or print name) certify that the corner location on this record was determined by me or under my direction and control and that this U.S. Public Land Survey Monument Record is correct and complete to the best of my knowledge and belief.

Milo E. Stefan — 4/3/1991

Signature — Date

WISCONSIN MILO E. STEFAN S-1258 RHINELANDER, WIS. LAND SURVEYOR

Index No. E-25

Stamp 36C 7010000