

CERTIFIED LAND CORNER RESTORATION

State of Wisconsin }
County of Oneida } ss.

I James D. Rein, do hereby certify that on the 30th day of July, 1979, I found evidence of the Southeast corner of Section 2 Township 36 North Range 7 East, Fourth Principal Meridian, as described hereon; and that from this evidence I established a new monument and accessories as described hereon to perpetuate the original location of this corner:

Description of original monument and accessories and subsequent restorations:

November 18th, 1862 Joseph H. Jenkins, Deputy Surveyor set wood post witnessed by a 16" white Pine N40W, 60 lks (39.60 feet); 18" White Pine S110W, 17 lks (11.22 feet); 18" white Pine N230E, 24 lks (15.84 feet) and 10" Elm S810E, 40 lks (26.40 feet)
January 18, 1898 B. F. Dorr corner set by SW tree. Other trees do not agree.
July 19th, 1937 V. M. Maine corner identified by stumps of original bearing trees, 20" white Pine stump N40W, .137 ch (9.04 feet); 18" white Pine S270E, .166 ch (10.96 feet) and 18" white Pine S110W, .17 ch (11.22 feet)
Set official Corner, marked BTs: 3" Black Oak, S790E, .17 1/2 ch (11.55 feet); 4" Black Oak S320E, .271 ch (17.89 feet)

Description of corner evidence found:


Oneida County brass capped 2" inside diameter galvanized iron pipe up 2' feet in open slashing. Witnessed by existing BTs
24" White Pine stump N40W, 8.9 feet (original)
White Pine stump S110W, 10 1/2 feet (original face of lower blaze fallen)
White Pine stump S290E, 11 feet (original)
10" Oak stump S340E, 18.05 feet (Maine)
12" Oak stumps S790E, 11.6 feet (Maine)

Description of ~~monument and~~ accessories I established to perpetuate the location of this corner:

Made BTs with P.K. nails driven in blaze
6" maple S620E, 47.55 feet (scribed "S.C. 12 BT")
5" Maple S670W, 3.19 feet (scribed "S.C. 11 BT")
No other trees near.



Section 2, T36N, R7E

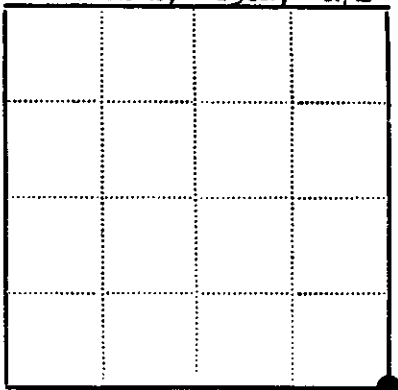

Legend: Solid circle - Corner monument restored; Open square -

Resident witnesses none

Dated at Minocqua, Wisconsin, this 10th day of September, 1979.

Signature [Handwritten James D. Rein] Title Reg. Land Surveyor (County Surveyor, Registered Land Surveyor, or other duly authorized official)


Office of REGISTER OF DEEDS County of Oneida

I hereby certify that the within instrument was filed in this office for record on the 17th day of September 1982, and was filed in Book No. Page No. of County Records.

Signature [Handwritten Doris Terage Kuehn] Title REGISTER OF DEEDS

Township, Range, Section, Index No., Page No.

3607020000

E-21