

CERTIFIED LAND CORNER RESTORATION

State of Wisconsin }
County of Oneida } ss.

I James D. Rein, do hereby certify that on the 25th day of July, 1979, I found evidence of the South one-quarter corner of Section 2 Township 36 North, Range 7 East, Fourth Principal Meridian, as described hereon; and that from this evidence I established a new monument and accessories as described hereon to perpetuate the original location of this corner:

Description of original monument and accessories and subsequent restorations:

November 20th, 1862 Joseph Jenkins, Deputy Surveyor set wood post, witnessed by a 9" Tamarack N41°W, 15 links (9.90 feet) and by a 12" Tamarack S80°E, 15 links (9.90 feet) January 18th, 1898 B. F. Dorr, Oneida County Surveyor found post witnessed by original BTs 12" Tamarack N28°W, 20 1/2 lks (13.53 feet) and an 18" Tamarack S80°E, 15 lks (9.90 feet) July 20th, 1936 V. M. Maine, Oneida County Surveyor found original BT stumps, 18" Tamarack S80°E, 15 lks (9.90 feet) and 12" Tamarack N28°W, 20 1/2 lks (13.53 feet) Set Official Corner. No other BTs near.

Description of corner evidence found:


Oneida County brass capped 2" inside diameter iron pipe up 3 feet and 1 foot from west edge of swamp. Original stumps plus or minus 10" Tamarack stump S80°E, 9.9 feet and remains of decayed stump N28°W, 13 1/2 feet A 12" White Birch scribed "1/4 S, 10.6' " bears S82°W, 10.78 feet.

Description of monument and accessories I established to perpetuate the location of this corner:

Piled stones around pipe to firm it up. Made BTs scribed "1/4 S BT" with PK nails driven in blaze as follows: 11" Soft maple S23°E, 30.81 feet 9" Soft Maple N33°W, 32.67 feet Drove P.K. nail in existing 12" White Birch S82°W, 10.78 feet



Section 2, T36N, R7E

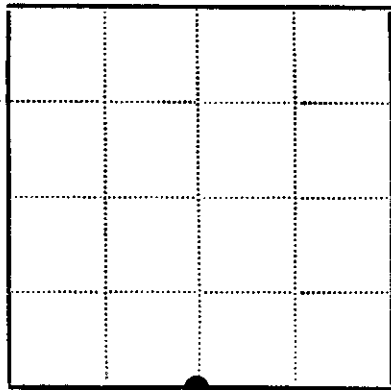

Resident witnesses None

Dated at Minocqua, Wisconsin, this 10th day of September, 1979.

Signature James D. Rein Title Reg. Land Surveyor (County Surveyor, Registered Land Surveyor, or other duly authorized official)


Office of REGISTER OF DEEDS County of Oneida

I hereby certify that the within instrument was filed in this office for record on the 17th day of September 1982, and was filed in Book No. Page No. of County Records.

Signature Doris Verage Kuehn Title REGISTER OF DEEDS

Township, Range, Section, Index No., Page No.

E-19

3607020020