

CERTIFIED LAND CORNER RESTORATION


State of Wisconsin }
County of Oneida } ss.

I, James D. Rein, do hereby certify that on the 27th day of July, 1979, I found evidence of the east one-quarter corner of Section 2, Township 36 North, Range 7 East, Fourth Principal Meridian, as described hereon; and that from this evidence I established new monument and accessories as described hereon to perpetuate the original location of this corner:


Description of original monument and accessories and subsequent restorations:
November 19th, 1862, Joseph H. Jenkins, Deputy Surveyor set wood post witnessed by a 10" White Pine N15°W, 9 links (5.94 feet) and by a 9" wh. Pine S16°E, 19 lks (12.54 feet)
August 18th, 1937 V. M. Maine found Government stake identified by stumps of original BTs, 10" White Pine N15°W, .09 ch. (5.94 feet) and 9" white Pine S15°E, .19 ch (12.54 feet). Set Official Corner, marked BTs 3 1/2" Black Oak N54°E, .278 ch (18.35 feet); 16" White Pine stump N46°E, .258 ch (17.03 feet) and 3" Black Oak S27°E, .10 1/2 ch (6.93 feet)

Description of corner evidence found:
Oneida County brass capped 2" inside diameter galvanized iron pipe up 2' feet and 30 feet south from edge of swamp. Corner is located in logging slashing.
Existing BTs
10" White pine stump N12°W, 6.05 feet (Original scar visible)
12" Oak stump N47°E, 18.25 feet (Maine)
8" Oak stump S34°E, 6.70 feet (Maine)

Description of monument and accessories I established to perpetuate the location of this corner:
made BTs scribed "1/4 S BT" with P.K. nails driven in blaze as follows:
7" Tamarack N23°W, 75.40 feet
8" Oak N65°W, 11.82 feet
No other trees near

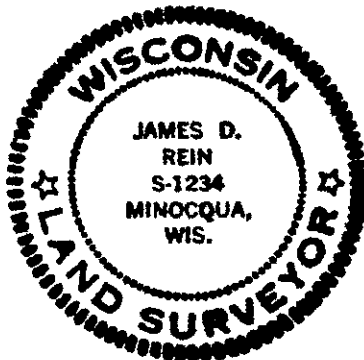

Section 2, T36N, R7E

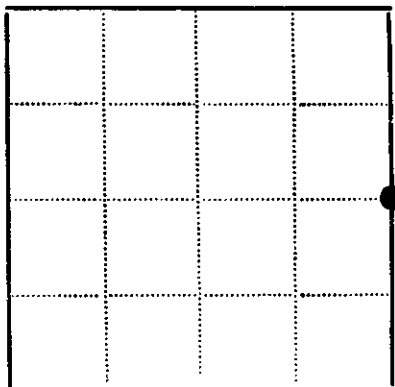

● - Corner monument restored
□ -

Resident witnesses... none

Dated at Minocqua, Wisconsin, this 10th day of September, 1979.

Signature James D. Rein Title Reg. Land Surveyor
(County Surveyor, Registered Land Surveyor, or other duly authorized official)

Surveyors Registration No. S-1234

Office of REGISTER OF DEEDS County of Oneida

I hereby certify that the within instrument was filed in this office for record on the 17th day of September, 1982 and was filed in Book No. Page No. of County Records.

Signature Doris Terage Kuehn Title REGISTER OF DEEDS

Township, Range, Section, Index No., Page No.

3607022000

C-21