

CERTIFIED LAND CORNER RESTORATION



State of Wisconsin }
County of Oneida } ss.

I James D. Rein, do hereby certify that on the 25th day of July, 1979, I found evidence of the west one-quarter corner of Section 2 Township 36 North, Range 7 East, Fourth Principal Meridian, as described hereon; and that from this evidence I established a new monument and accessories as described hereon to perpetuate the original location of this corner:

Description of original monument and accessories and subsequent restorations:
November 20th, 1862 Joseph H. Jenkins, Deputy Surveyor set wood post witnessed by a 10" Birch S51°E, 7 lks (4.62 feet) and by a 6" Hemlock N22°W, 22 lks (14.52 feet)
September 16th, 1893 B. F. Dorr, Oneida County Surveyor set new post.
July 22nd, 1937 V. M. Maine, Oneida County Surveyor found original 1/4 stake, B.V. dorr's old post and original BT stumps. Set official Corner to re-monument position. No BTs near.

Description of corner evidence found:
Oneida County brass capped 2" diameter inside galvanized iron pipe up 3 feet and 3 feet east of recently repaired old wire fence which runs North and South. Old cedar post with location Tag bears North, plus or minus 124 feet. No BTs visible.

Description of monument and accessories I established to perpetuate the location of this corner:
Made BTs scribed "1/4 S BT" with P.K. nails driven in blaze as follows:
7" white Birch, S76°E, 24.70 feet
8" Soft Maple N61°E, 25.37 feet
11" white Birch S68°W, 11.97 feet

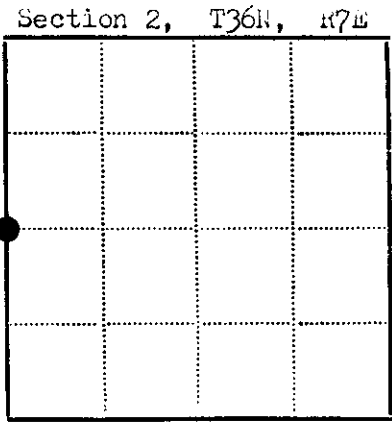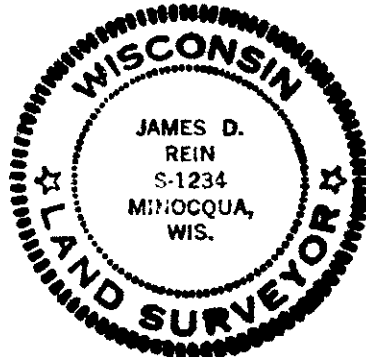

● - Corner monument restored
□ -

Resident witnesses None

Dated at Minocqua, Wisconsin, this 10th day of September, 1979.

Signature James D. Rein Title Reg. Land Surveyor
(County Surveyor, Registered Land Surveyor, or other duly authorized official)

Surveyors Registration No. S-1234

Office of REGISTER OF DEEDS County of Oneida

I hereby certify that the within instrument was filed in this office for record on the 17th day of September, 1982, and was filed in Book No. Page No. of County Records.

Signature Doris Verage Kuhn, Title REGISTER OF DEEDS

Township, Range, Section, Index No., Page No.

3607032000

C-17