U.S. PUBLIC LAND SURVEY MONUMENT RECORD

Note: This form is intended and designed to fulfill all requirements of Wisconsin Administrative Code, Chapter A-E 7.08 U.S Public Land Survey Monument Record (3) (a) (b) (c) (d) (e) (f) (g) (h) (i). An additional sheet may be added if necessary to conform with said requirements.

(a) Corner location: Township 36 North

Range 7 East/~~West~~

Town/~~City/Village~~ Woodboro

County Oneida

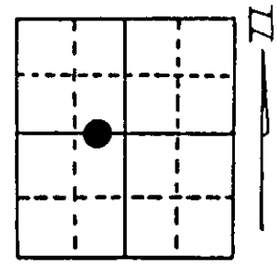

Section 5

(b) (f) (g) (h) Description of monument found at this corner and if it was accepted, state all evidence (material, testimonial, occupational, plats, records, other monuments) used as a basis for accepting. If not accepted or if nothing was found, state evidence used as basis for establishing location. If reestablished through lost corner proportionate methods, indicate all monuments, distances and directions used to establish. Indicate type of monument found or set and sign post.

2/2/1982 - Jean Resvick (S-802) established this corner and set a PK nail in road with Witness Corner (1" iron pipe) North 33.0'.

5/24/1995 - Milo E. Stefan found Resvick's PK nail and 1" iron pipe with three Aspen ties: 5" Aspen, N37°W, 18.98' 5" Aspen, S26°W, 6.28'
4" Aspen, N3°E, 15.18'

10/11/1995 - Milo E. Stefan returned and placed a railroad spike in road for corner and took three BTs to the corner and placed a plastic sign post.

(c) (d) (e) Plan view of corner with ties to at least 4 witness monuments. If in disagreement with previously established corner, show the distances between the two corners and also indicate the ties to the disputed corner.

1) Railroad spike in road surface.
2) 6" Aspen, N2°E, 48.12'.
3) 6" Aspen, N52°E, 93.43'.
4) 20" White Pine, N12°W, 49.21'.
5) 1" Iron Pipe, N1°-48'-13"W, 33.0'.
6) Plastic Sign Post, North, 33.4'.

Distances to nail in side of BTs.
Stump blazes scribed "BT".
BT tags placed on face of each BT.

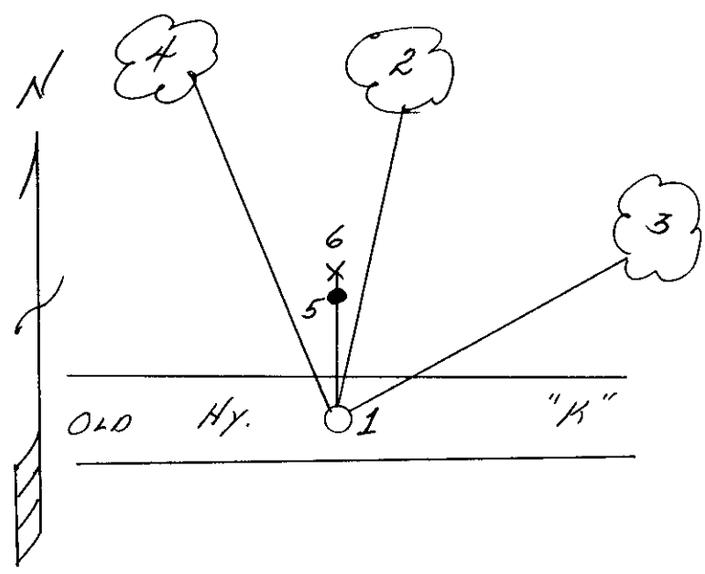

(i) I, Milo E. Stefan (type or print name) certify that the corner location on this record was determined by me or under my direction and control and that this U.S. Public Land Survey Monument Record is correct and complete to the best of my knowledge and belief.

Milo E. Stefan December 17, 1995

Signature Date

WISCONSIN MILO E. STEFAN S-1568 RHINELANDER, WIS. LAND SURVEYOR

Index No. C-6, 7

Stamp 3607052025