

U.S. PUBLIC LAND SURVEY MONUMENT RECORD


Note: This form is intended and designed to fulfill all requirements of Wisconsin Administrative Code, Chapter A-E 7.08 U.S. Public Land Survey Monument Record (3) (a) (b) (c) (d) (e) (f) (g) (h) (i). An additional sheet may be added if necessary to conform with said requirements.

(a) Corner location: Township 36 North

Range 7 East/West

Town/City/Village Woodboro

County Oneida

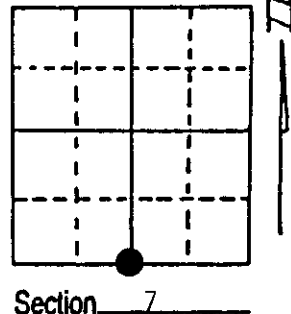

(b) (f) (g) (h) Description of monument found at this corner and if it was accepted, state all evidence (material, testimonial, occupational, plats, records, other monuments) used as a basis for accepting. If not accepted or if nothing was found, state evidence used as basis for establishing location. If reestablished through lost corner proportionate methods, indicate all monuments, distances and directions used to establish. Indicate type of monument found or set and sign post.

November 1862 - Joseph H. Jenkins established this corner and set a wood post and one BT: 20" Y. Pine, West, 550 Links.

12/06/1909 - Vaughan used corner to subdivide Section 7.

9/29/1937 - Maine found stump of original BT with scribing visible. He set stake and two new BTs:
 20" Y. Pine, S67°E, 44.8 Links 16" Y. Pine, N76°E, 35 1/2 Links


1966 - Owens - Illinois used corner to work O-I lands.

7/25/1989 - Milo E. Stefan found iron pipe with collar of concrete around it. This iron pipe supported by remains of original Yellow Pine BT, west, 550 links. We replaced iron pipe with an Oneida County aluminum monument, made new BTs and set a plastic sign post.

(c) (d) (e) Plan view of corner with ties to at least 4 witness monuments. If in disagreement with previously established corner, show the distances between the two corners and also indicate the ties to the disputed corner.

- 1) 2" x 30" Aluminum Oneida County Monument
- 2) 5" Red Maple, N25°E, 37.76'
- 3) 6" White Pine, S77°E, 26.64'
- 4) 5" White Pine, S19°E, 29.64'
- 5) 12" White Pine, S86°W, 32.77'
- 6) Plastic sign post, NE, .50'

Distances to nail in side of BTs.
 BTs scribed "BT" in stump blaze.

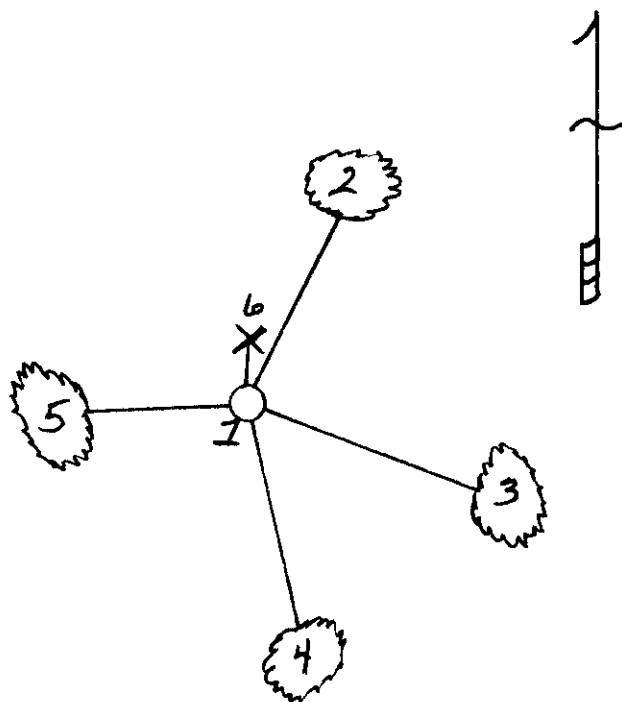

(i) I, Milo E. Stefan
 (type or print name) certify that the corner location on this record was determined by me or under my direction and control and that this U.S. Public Land Survey Monument Record is correct and complete to the best of my knowledge and belief.

Milo E. Stefan
 Signature

8/5/89
 Date



Index No. J-3

3607070020