


U.S. PUBLIC LAND SURVEY MONUMENT RECORD

Note: This form is intended and designed to fulfill all requirements of Wisconsin Administrative Code, Chapter A-E 7.08 U.S. Public Land Survey Monument Record (3) (a) (b) (c) (d) (e) (f) (g) (h) (i). An additional sheet may be added if necessary to conform with said requirements.

(a) Corner location: Township 36 North
 Range 7 East/West

Town/City/Village Woodboro
 County Oneida

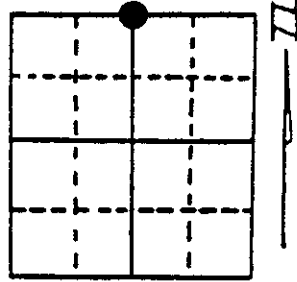

Section 16


(b) (f) (g) (h) Description of monument found at this corner and if it was accepted, state all evidence (material, testimonial, occupational, plats, records, other monuments) used as a basis for accepting. If not accepted or if nothing was found, state evidence used as basis for establishing location. If reestablished through lost corner proportionate methods, indicate all monuments, distances and directions used to establish. Indicate type of monument found or set and sign post.

- 11/1862 - Joseph H. Jenkins established this corner and set a wood post with two BTs:
 6" Spruce, S30°W, 22 Links 6" Spruce, N10°W, 25 Links
- 7/30/1937 - Maine found stumps of both original BTs with marks plain on northwest one. He set a 2" x 60" iron pipe with brass cap. No BTs available.
- 3/1/1990 - Milo E. Stefan found Maine's monument in good condition, made four new BTs and set plastic sign post.

(c) (d) (e) Plan view of corner with ties to at least 4 witness monuments. If in disagreement with previously established corner, show the distances between the two corners and also indicate the ties to the disputed corner.

- 1) 2" x 60" iron pipe with brass cap
- 2) 3" Black Spruce, N61°E, 17.65'
- 3) 2" Black Spruce, S31°E, 12.11'
- 4) 4" Black Spruce, S32°W, 11.85'
- 5) 3" Black Spruce, N30°W, 11.45'
- 6) Plastic sign post, South, .8'

Distances to nail in side of BT
 BTs scribed "BT" in stump blaze

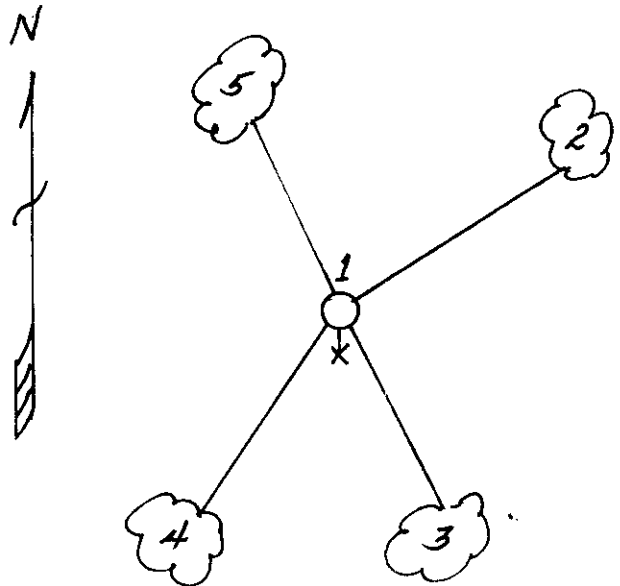

(i) I, Milo E. Stefan
 (type or print name) certify that the corner location on this record was determined by me or under my direction and control and that this U.S. Public Land Survey Monument Record is correct and complete to the best of my knowledge and belief.

Milo E. Stefan 3/2/90
 Signature Date



Index No. J-11

3607090020
 Stamp