


U.S. PUBLIC LAND SURVEY MONUMENT RECORD

Note: This form is intended and designed to fulfill all requirements of Wisconsin Administrative Code, Chapter A-E 7.08 U.S. Public Land Survey Monument Record (3) (a) (b) (c) (d) (e) (f) (g) (h) (i). An additional sheet may be added if necessary to conform with said requirements.

(a) Corner location: Township 36 North
 Range 7 East/West
 Town/City/Village Woodboro
 County Oneida

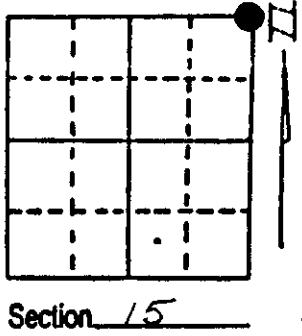


(b) (f) (g) (h) Description of monument found at this corner and if it was accepted, state all evidence (material, testimonial, occupational, plats, records, other monuments) used as a basis for accepting. If not accepted or if nothing was found, state evidence used as basis for establishing location. If reestablished through lost corner proportionate methods, indicate all monuments, distances and directions used to establish. Indicate type of monument found or set and sign post.

November, 1862, Joseph Jenkins set a wood post: Aspen 9" S7E, 231ks., Aspen 7" S27W, 611ks., Fir 6" N52E, 301ks., Aspen 10" N45W, 411ks.

 8-23-37, Maine set an Official Corner: W.Pine Stp. 15" N36E, .52.

 5-17-89, I found and accepted a 2 1/2" dia. brass capped iron pipe: set spike in Maple 6" N56W, 8.70', set spike in Maple 9" S54W, 25.78', set spike in W.Birch 5" S15W, 26.34', set spike in Cherry 4" N79E, 17.84', set plastic survey marker sign S39E, 1.2'.

(c) (d) (e) Plan view of corner with ties to at least 4 witness monuments. If in disagreement with previously established corner, show the distances between the two corners and also indicate the ties to the disputed corner.

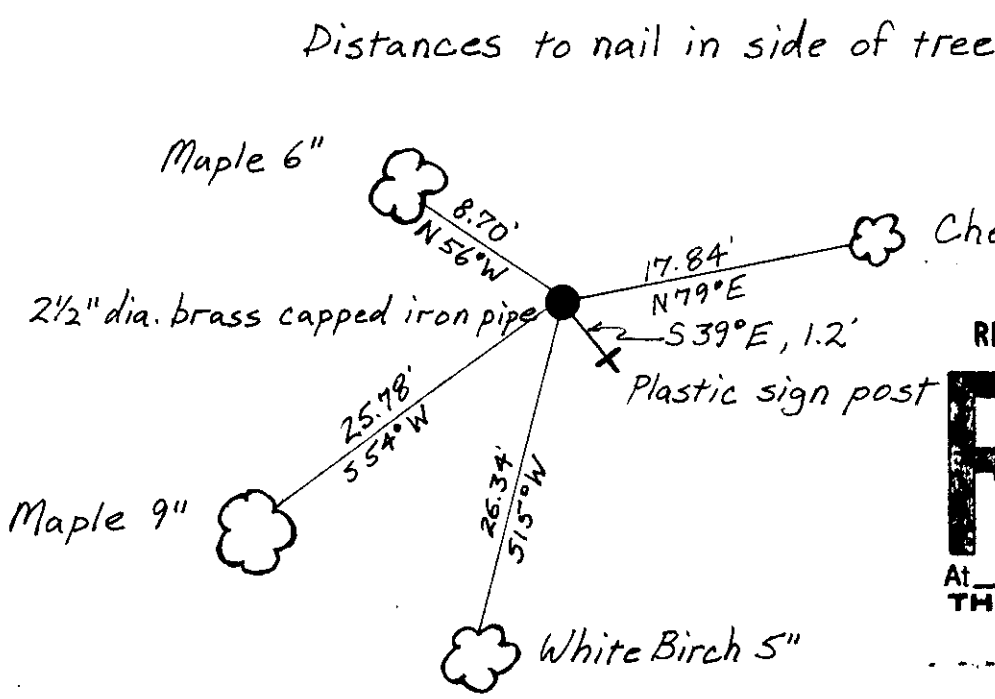

REGISTER OF DEEDS OFFICE
 ONEIDA COUNTY, WIS.
FILED
 JUL 17 1989
 At _____ O'Clock _____ M
THOMAS H. LEIGHTON
 REGISTER OF DEEDS

JEFFREY W. AUSTIN S-1885

(i) I, _____
 (type or print name) certify that the corner location on this record was determined by me or under my direction and control and that this U.S. Public Land Survey Monument Record is correct and complete to the best of my knowledge and belief.

Signature *Jeffrey W. Austin* Date JUNE 30, 1989



Index No. 2-17

3607100000