U.S. PUBLIC LAND SURVEY MONUMENT RECORD

Note: This form is intended and designed to fulfill all requirements of Wisconsin Administrative Code, Chapter A-E 7.08 U.S. Public Land Survey Monument Record (3) (a) (b) (c) (d) (e) (f) (g) (h) (i). An additional sheet may be added if necessary to conform with said requirements.

(a) Corner location: Township 36 North

Range 7 East/~~West~~

Town/~~City/Village~~ Woodboro

County Oneida

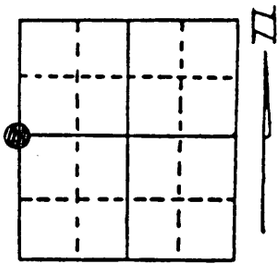

Section 11

(b) (f) (g) (h) Description of monument found at this corner and if it was accepted, state all evidence (material, testimonial, occupational, plats, records, other monuments) used as a basis for accepting. If not accepted or if nothing was found, state evidence used as basis for establishing location. If reestablished through lost corner proportionate methods, indicate all monuments, distances and directions used to establish. Indicate type of monument found or set and sign post.

1862 - Joseph H. Jenkins established this corner and set a wood post with two BTs:
18" Hemlock, N45°E, 23 Links 16" Hemlock, S59°W, 27 Links

9/11/1890 - Dorr restored corner and made two new BTs:
18" Y. Pine, S34½°E, 14 Links 18" Y. Pine, N72½°W, 35¼ Links

8/24/1937 - Maine found Dorr's corner and placed a 2" x 60" iron pipe/BC and made one new reference: 26" White Pine Stump, N7½°E, 70 Links

11/19/1990 - Milo E. Stefan found Maine's monument in excellent condition. Sliver of scribing on Y. Pine Stump, S34½°E, 9.25'. Other BTs by Dorr and Maine are badly decayed stumps.

We made four new BTs and set plastic sign post.

(c) (d) (e) Plan view of corner with ties to at least 4 witness monuments. If in disagreement with previously established corner, show the distances between the two corners and also indicate the ties to the disputed corner.

1) 2" x 60" iron pipe with brass cap
2) Large Red Pine Stump, S34½°E, 9.25 feet
3) Large Red Pine Stump, N72½°W, 23.26 feet
4) Large White Pine Stump, N7½°E, 46.20 feet
5) 10" Red Maple, N20°E, 34.11 feet
6) 5" Red Maple, N67°E, 45.81 feet
7) 6" Black Cherry, S52°E, 21.88 feet
8) 10" Red Oak, N83°W, 16.45 feet
9) Plastic sign post, Southwest, 1.0 feet

Distances to nail in side of BTs.
Stump blaze scribed "BT".

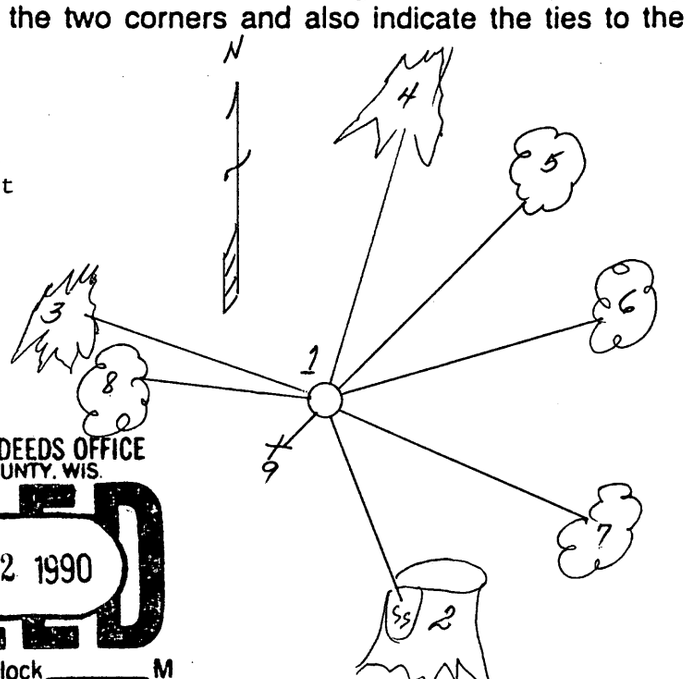

REGISTER OF DEEDS OFFICE
ONEIDA COUNTY, WIS.
FILED
DEC 12 1990
At ____ O'Clock ____ M
THOMAS H. LEIGHTON
REGISTER OF DEEDS

(i) I, Milo E. Stefan (type or print name) certify that the corner location on this record was determined by me or under my direction and control and that this U.S. Public Land Survey Monument Record is correct and complete to the best of my knowledge and belief.

Milo E. Stefan 12/5/90

Signature Date

WISCONSIN
MILO E. STEFAN
S-1558
RHINELANDER, WIS.
LAND SURVEYOR

Index No. G-17

Stamp 3607102000