

This form is intended to fulfill the requirements of Chapter A-E 7.08 (3)(a) thru (i) U.S. Public Land Survey Monument Location Record, Wisconsin Administrative Code. Use the reverse side of form for continuation.

U.S. PUBLIC LAND SURVEY MONUMENT LOCATION RECORD

Recorders Data

USPLS CORNER: WEST 1/4 SECTION: 18 TOWNSHIP: 36 NORTH RANGE: 8 EAST

NAME OF WATERWAY FOR M.C. CORNER: N/A

SECTION LINE: N/A

(CITY)(VILLAGE)(TOWN) OF: CRESCENT

COUNTY OF: ONEIDA

ONEIDA

Description of monument found or placed and all other evidence used as the basis for monument location; including monuments and related measurements required if the corner location was reestablished by lost corner proportionate methods. Also indicate name of original surveyor, original survey date and the corner monument, bearing trees, witness or other reference monuments established; including measured bearing and distance ties, from available records.

Found and accepted an old undisturbed 6" dia. concrete monument with standard stamped U.S. GLO brass tablet in top 3" above existing grade. Also found the rotted remains of former white poly aerial photo panel marker centered on the monument in ground cover surface, a standard white poly "T" marker post along North side of the monument and an old 1.5" dia. uncapped iron pipe flush with grade along the East side of the monument.


In September 1860, Alfred Millard/GLO set a wood post as the original corner and marked OBTS: a 20" Pw S71°E 23 links, now a badly rotted root crown at grade S67°E 14.7' to center, and a 12" Pw N52°W 22 links, also now a badly rotted root crown at grade at same bearing 15.3' to center. In 1942, Craig & Shearer/GLO, set the foregoing concrete monument from the stumps of both original GLO BTs and marked new BTs: a 16" Pn S56.75°E 28 links found OK and used for new ties below, and an 8" Poplar S5.25°W 36 links found as a 17" Poplar S09°W 23.87' to 40d spike in left face.

In 1974, Northwoods Surveyors of Minocqua, Wis. also found and accepted the foregoing concrete monument and noted BTs: a 16" Pw S61°E 18.7' (1942 GLO BT) and a 11" Aspen S05°W 23.4' (1942 GLO BT) per plat of survey filed as C-348 in Oneida County survey records, which I found OK and both with plain upper and lower face blazes fissures or overgrowth scars. A 13" Bw with white/black survey marker sign on face was also found N70°W 3'+/- from the corner monument.

Recovery completed September 30, 1999; there were no direct witnesses. I painted all old blazes blaze orange and nailed standard BT signs on the upper face of the found 1942 GLO BTs.


Plan view map of monument location with bearing and distance ties to a minimum of four(4) described witness or reference monuments of concrete, natural stone, iron, live bearing trees or equivalent material. If applicable, also show a minimum of two(2) bearing and distance ties to any other monument found and not accepted; including the bearing and distance from the accepted monument.

- WITNESS MONUMENT TIES:**
- ① New BT South trunk of twin 6" Mr S78°E 16.25'
 - ② Old BT 21" Pr with upper & lower face blazes shut but plain S55°E at 18.81'
 - ③ Old BT 15" Pr with upper & lower face blazes plain and 40d spike in right face S22°E 22.50' to my PK nail & washer in right face.
 - ④ New BT 7" Fir S12°W 31.08'
 - ⑤ Old BT 7" Fir with upper blaze shut and lower blaze open N29°W at 22.33'.

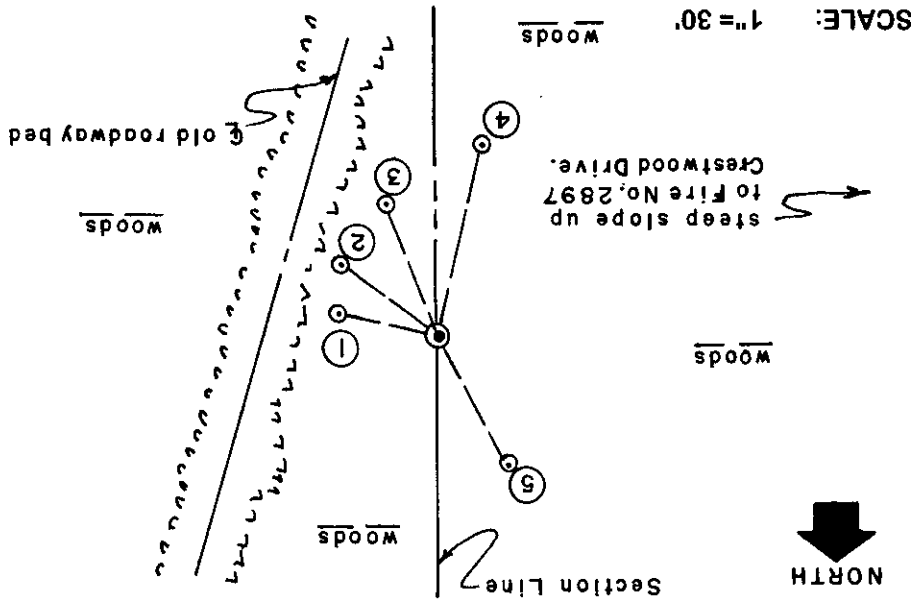

Unless otherwise indicated, all bearing tree ties are to a .25" dia. by 2.5" long PK nail with a 1.25" dia. steel washer driven into unblazed right face and a .25" dia. by 2.5" long PK nail with a 2" dia. steel washer stamped BT is also driven into unblazed face of bearing tree at DBH; the basis for measured bearings is by compass to nearest degree and all the distances are measured horizontal by steel tape corrected to nearest 1/100th foot at standard temperature of 68° F.

RLS SEAL:

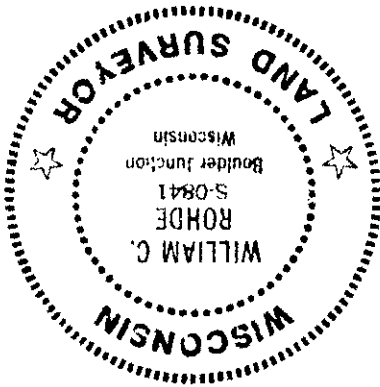

LAND SURVEYOR CERTIFICATE:
 I, William C. Rohde, hereby certify that I am duly licensed as a Professional Land Surveyor in the State of Wisconsin; that this USPLS monument location was determined by me and/or under my direct supervision and control; and that this U.S. Public Land Survey Monument Location Record is true and correct to the best of my knowledge and belief.

Signed: *William C. Rohde*
 William C. Rohde
 RLS 841

SECTION LOCATION MAP

		18	

INDEX NO. L 1
 3607132000