U.S. PUBLIC LAND SURVEY MONUMENT RECORD

Note: This form is intended and designed to fulfill all requirements of Wisconsin Administrative Code, Chapter A-E 7.08 U.S. Public Land Survey Monument Record (3) (a) (b) (c) (d) (e) (f) (g) (h) (i). An additional sheet may be added if necessary to conform with said requirements.

(a) Corner location: Township 36 North

Range 7 East/~~West~~

~~Town/City/Village~~ Woodboro

County Oneida

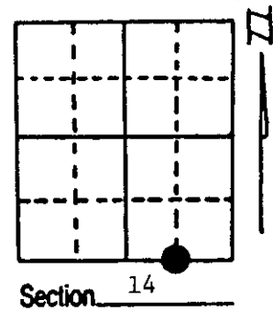

(b) (f) (g) (h) Description of monument found at this corner and if it was accepted, state all evidence (material, testimonial, occupational, plats, records, other monuments) used as a basis for accepting. If not accepted or if nothing was found, state evidence used as basis for establishing location. If reestablished through lost corner proportionate methods, indicate all monuments, distances and directions used to establish. Indicate type of monument found or set and sign post.

Dec. 1963 - James Griffin established this corner when he platted Nose Lake lots. He placed a 1 1/2" x 24" iron pipe with one BT: a 7" Maple, S4°W, 8.1'.

6/14/1995 - Milo E. Stefan found Griffin's iron pipe 8" below ground line with progeny of Maple BT, S4°W, 8.1'.

8/28/1995 - Milo E. Stefan placed a 2" x 30" aluminum monument over the iron pipe, made four new references and set plastic sign post.

(c) (d) (e) Plan view of corner with ties to at least 4 witness monuments. If in disagreement with previously established corner, show the distances between the two corners and also indicate the ties to the disputed corner.

1) 1 1/2" x 24" Iron pipe inside of a 2" x 30" aluminum monument.
2) 2" Iron pipe, N44°E, 30.57'. (Lot corner to lot 18.)
3) 4" Red Oak, N53°E, 11.62'.
4) 12" Red Oak, S22°W, 12.84'.
5) Power Pole, N12°E, 31.08'.
6) Plastic Sign Post, North, .8'.

Distances to nail in side of BTs.
BT stumps scribed "BT".
BT tags placed on bearing trees.

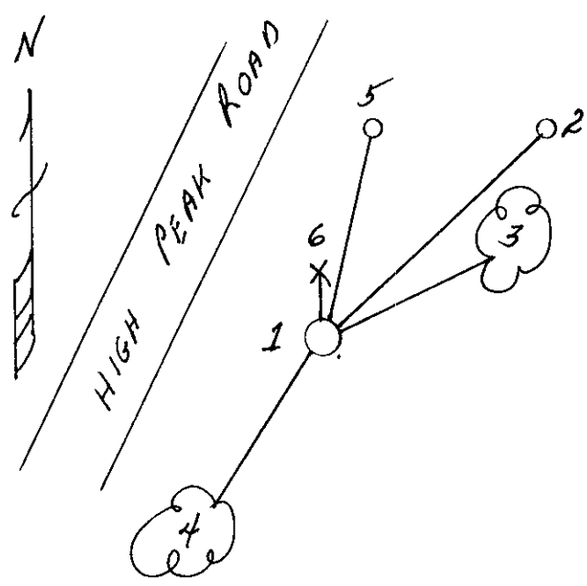

REGISTER OF DEEDS OFFICE
ONEIDA COUNTY, WIS.
FILED
SEP 19 1995
At _____ O'Clock _____ M
THOMAS H. LEIGHTON
REGISTER OF DEEDS

(i) I, Milo E. Stefan (type or print name) **certify that the corner location on this record was determined by me or under my direction and control and that this U.S. Public Land Survey Monument Record is correct and complete to the best of my knowledge and belief.**

WISCONSIN MILO E. STEFAN S-1558 RHINELANDER, WIS. LAND SURVEYOR

Milo E. Stefan — September 11, 1995

Signature — Date

Index No. N-20

36C714C010