


# U.S. PUBLIC LAND SURVEY MONUMENT RECORD

**Note:** This form is intended and designed to fulfill all requirements of Wisconsin Administrative Code, Chapter A-E 7.08 U.S. Public Land Survey Monument Record (3) (a) (b) (c) (d) (e) (f) (g) (h) (i). An additional sheet may be added if necessary to conform with said requirements.

(a) Corner location: Township 36 North  
 Range 7 East/West

Town/City/Village Woodboro  
 County Oneida

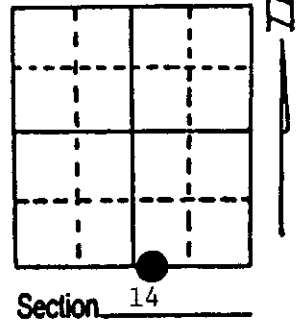

(b) (f) (g) (h) Description of monument found at this corner and if it was accepted, state all evidence (material, testimonial, occupational, plats, records, other monuments) used as a basis for accepting. If not accepted or if nothing was found, state evidence used as basis for establishing location. If reestablished through lost corner proportionate methods, indicate all monuments, distances and directions used to establish. Indicate type of monument found or set and sign post.

- 12/1963 - James Griffin placed a 1 1/2" x 24" iron pipe, 1 1/2 chains East of Quarter Corner which falls in Finger Lake. Restored from Maine's work below.
- 5/23/1995 - Milo E. Stefan found this iron pipe and tied to traverse of Section Line.
- 8/29/1995 - Milo E. Stefan placed a 2" x 30" aluminum monument to witness the Quarter Corner to Sections 14 and 23.


**SUPPLEMENTAL INFORMATION ADDED 2/2/1996:**

- 1862 Joseph Jenkins calls for 1/4 Corner in pond and sets witness on West side of pond: Birch 7", N25°E, 16 links; Birch 10", S20°W, 12 links.
- 1891 Dorr, book 22, page 38, sets witness 1.5 chain East of 1/4 corner position in lake, Pine 12", S35°E, 14 1/4 links.
- 1937 Maine, book 1, page 172, found Dorr's BT, sets an Oak stake.

(c) (d) (e) Plan view of corner with ties to at least 4 witness monuments. If in disagreement with previously established corner, show the distances between the two corners and also indicate the ties to the disputed corner.

- 1) 2" x 30" Aluminum monument with Griffin's iron pipe inside.
- 2) 10" Red Oak, N28°E, 26.11'.
- 3) 6" Red Oak, N83°E, 3.90'.
- 4) 10" Red Oak, S67°E, 35.13'.
- 5) 12" Red Oak, S5°W, 52.01'.
- 6) Plastic Sign Post, North, 1.0'.

Distances to nail in side of BTs.  
 Stump blazes scribed "BT".  
 BT tags on each bearing tree.

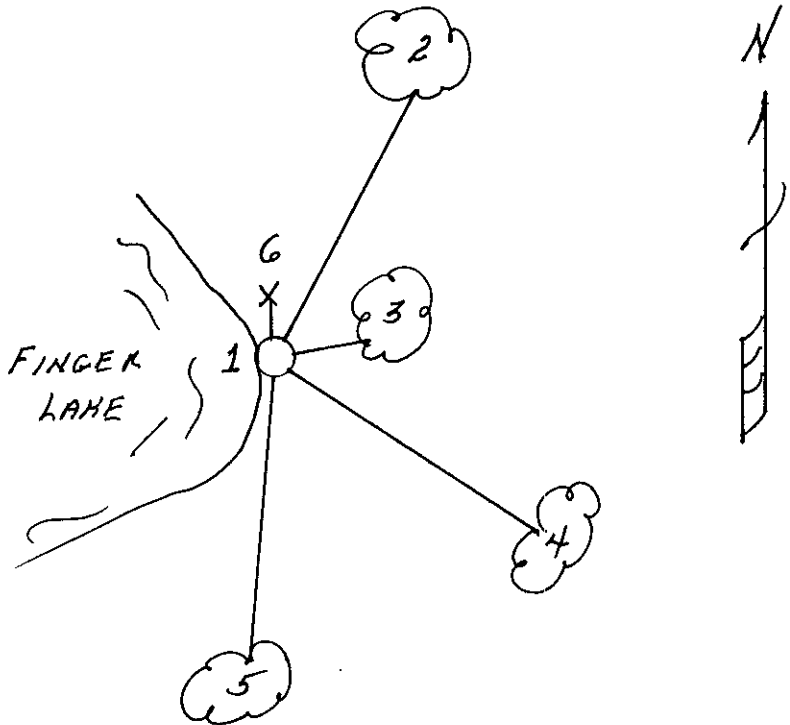

(i) I, Milo E. Stefan  
 (type or print name) certify that the corner location on this record was determined by me or under my direction and control and that this U.S. Public Land Survey Monument Record is correct and complete to the best of my knowledge and belief.

Milo E. Stefan                      September 11, 1995  
 Signature    Date



Index No. 19. 20

3607140018