

U.S. PUBLIC LAND SURVEY MONUMENT RECORD


Note: This form is intended and designed to fulfill all requirements of Wisconsin Administrative Code, Chapter A-E 7.08 U.S. Public Land Survey Monument Record (3) (a) (b) (c) (d) (e) (f) (g) (h) (i). An additional sheet may be added if necessary to conform with said requirements.

(a) Corner location: Township 36 North

Range 7 East/West

Town/City/Village Woodboro

County Oneida

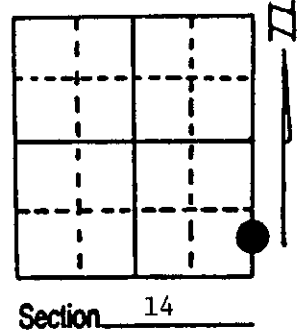


(b) (f) (g) (h) Description of monument found at this corner and if it was accepted, state all evidence (material, testimonial, occupational, plats, records, other monuments) used as a basis for accepting. If not accepted or if nothing was found, state evidence used as basis for establishing location. If reestablished through lost corner proportionate methods, indicate all monuments, distances and directions used to establish. Indicate type of monument found or set and sign post.

- Nov. 1862 - Joseph H. Jenkins established this corner 4.40 chains North of the Section Corner which falls in Nose Lake. He set a wood post for the M.C./2 BTs:
12" Red Pine, N32°E, 15 Links (9.90') 12" Red Pine, N56°W, 25 Links (16.50')
- 7/9/1937 - Vern Maine found old stake and stumps of original BTs. He placed a 2" x 60" iron pipe - no new BTs and ran line North, along fence.
- 8/27/1995 - Milo E. Stefan found Maine's monument in good condition, tied it off with four new BTs and placed plastic sign post.

(c) (d) (e) Plan view of corner with ties to at least 4 witness monuments. If in disagreement with previously established corner, show the distances between the two corners and also indicate the ties to the disputed corner.

- 1) 2" x 60" Iron pipe/brass cap.
- 2) 10" Red Oak, N11°E, 30.00'.
- 3) 12" Red Oak, N48°E, 26.99'.
- 4) 3" Red Pine, East, 35.72'.
- 5) 14" Red Oak, N50°W, 24.62'.
- 6) Plastic Sign Post, North, .3'.

Distances to nail in side of BTs.
Stump blazes scribed "BT".
BT tags placed on each bearing tree.

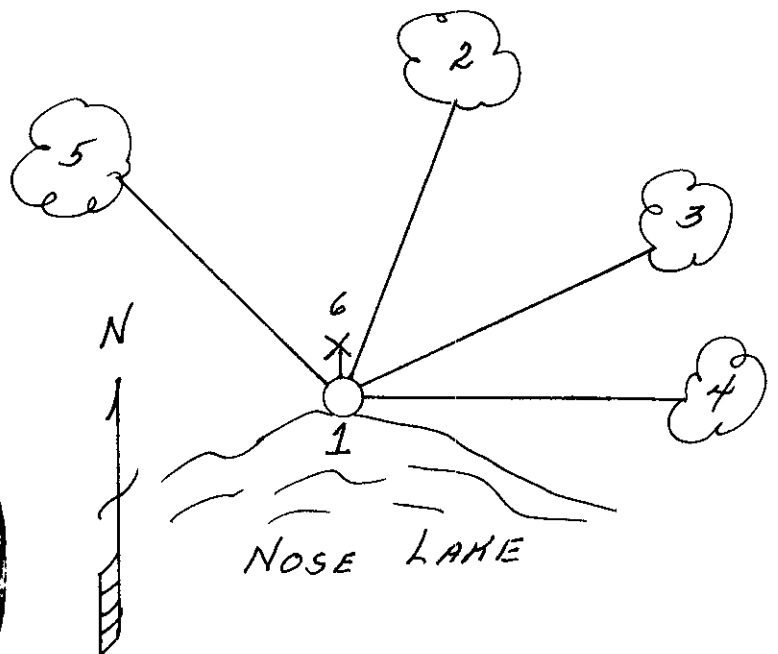

REGISTER OF DEEDS OFFICE
ONEIDA COUNTY, WIS.
FILED
SEP 19 1995
At 10 O'Clock M
THOMAS H. LEIGHTON
REGISTER OF DEEDS

(i) I, Milo E. Stefan
(type or print name) certify that the corner location on this record was determined by me or under my direction and control and that this U.S. Public Land Survey Monument Record is correct and complete to the best of my knowledge and belief.

Milo E. Stefan
Signature

September 11, 1995
Date



Index No. M. N. - 21

3607140500