


# U.S. PUBLIC LAND SURVEY MONUMENT RECORD

**Note:** This form is intended and designed to fulfill all requirements of Wisconsin Administrative Code, Chapter A-E 7.08 U.S. Public Land Survey Monument Record (3) (a) (b) (c) (d) (e) (f) (g) (h) (i). An additional sheet may be added if necessary to conform with said requirements.

(a) Corner location: Township 36 North  
 Range 7 East/West  
 Town/City/Village Woodboro  
 County Oneida

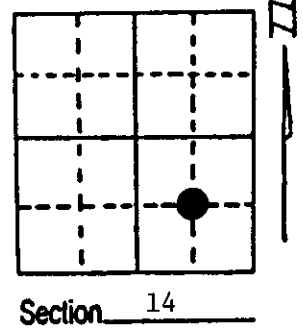



(b) (f) (g) (h) Description of monument found at this corner and if it was accepted, state all evidence (material, testimonial, occupational, plats, records, other monuments) used as a basis for accepting. If not accepted or if nothing was found, state evidence used as basis for establishing location. If reestablished through lost corner proportionate methods, indicate all monuments, distances and directions used to establish. Indicate type of monument found or set and sign post.

8/28/1995 - We established this corner at the intersection of the South and East 1/16 lines to Section 14.  
 We placed a 2" x 30" aluminum monument with four bearing trees to mark this corner position.

(c) (d) (e) Plan view of corner with ties to at least 4 witness monuments. If in disagreement with previously established corner, show the distances between the two corners and also indicate the ties to the disputed corner.

- 1) 2" x 30" Aluminum monument.
- 2) 14" Red Oak, S44°E, 20.60'.
- 3) 10" Red Oak, S10°E, 8.01'.
- 4) 10" Red Oak, West, 7.62'.
- 5) 9" Red Oak, N8°W, 20.23'.
- 6) Plastic Sign Post, North, 1.0'.

Distances to nail in side of BTs.  
 Stump blazes scribed "BT".  
 BT tags placed on each bearing tree.

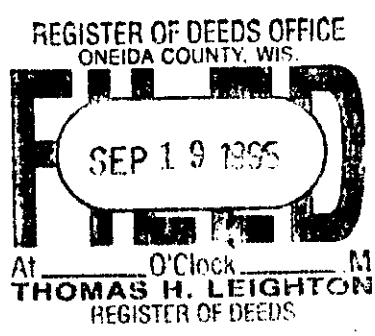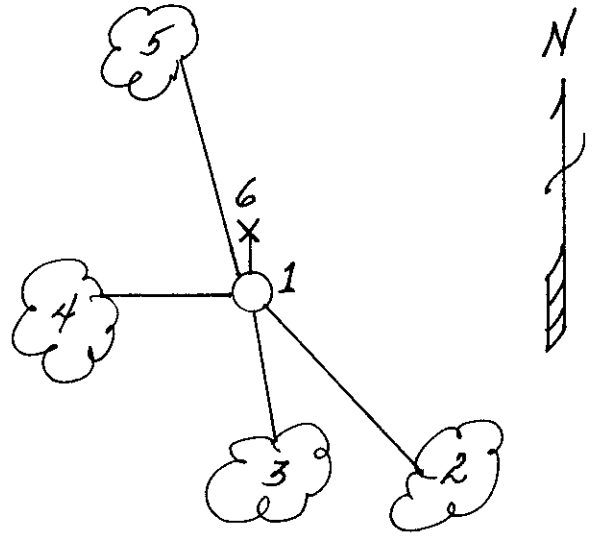

Index No. M-20

(i) I, Milo E. Stefan  
 (type or print name) certify that the corner location on this record was determined by me or under my direction and control and that this U.S. Public Land Survey Monument Record is correct and complete to the best of my knowledge and belief.

Milo E. Stefan Signature                      September 11, 1995 Date

3607141010