

U.S. PUBLIC LAND SURVEY MONUMENT RECORD


Note: This form is intended and designed to fulfill all requirements of Wisconsin Administrative Code, Chapter A-E 7.08 U.S. Public Land Survey Monument Record (3) (a) (b) (c) (d) (e) (f) (g) (h) (i). An additional sheet may be added if necessary to conform with said requirements.

(a) Corner location: Township 36 North

Range 7 East/West

Town/City/Village Woodboro

County Oneida

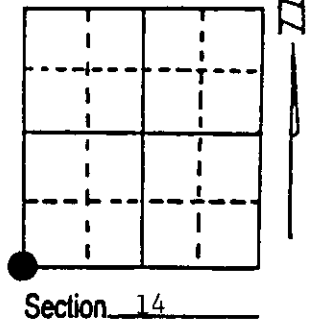

(b) (f) (g) (h) Description of monument found at this corner and if it was accepted, state all evidence (material, testimonial, occupational, plats, records, other monuments) used as a basis for accepting. If not accepted or if nothing was found, state evidence used as basis for establishing location. If reestablished through lost corner proportionate methods, indicate all monuments, distances and directions used to establish. Indicate type of monument found or set and sign post.

1862 - Joseph H. Jenkins established this corner and set a wood post with four BTs:
 8" Maple, N32°E, 7 Links 10" Birch, S51°E, 7 Links
 7" White Pine, S26°W, 30 Links 9" Y. Pine, N40°W, 12 Links


8/28/1937 - Maine set county monument from original Pine BTs. No new BTs made.

11/21/1990 - Milo E. Stefan found Maine's monument in excellent condition. Pine BTs now badly rotted stumps. Made four new BTs and set plastic sign post. Snowmobile trail Westerly 1 1/2 chains.

(c) (d) (e) Plan view of corner with ties to at least 4 witness monuments. If in disagreement with previously established corner, show the distances between the two corners and also indicate the ties to the disputed corner.

- 1) 2" x 60" iron pipe/brass cap
- 2) 12" Red Maple, N28°E, 37.97 feet
- 3) 12" Red Oak, S33°E, 52.05 feet
- 4) 12" White Birch, N86°W, 41.65 feet
- 5) 14" Red Oak, N38°W, 38.20 feet
- 6) Plastic sign post, West, 1.0 feet

Distances to nail in side of BTs.
 Stump blaze scribed "BT".

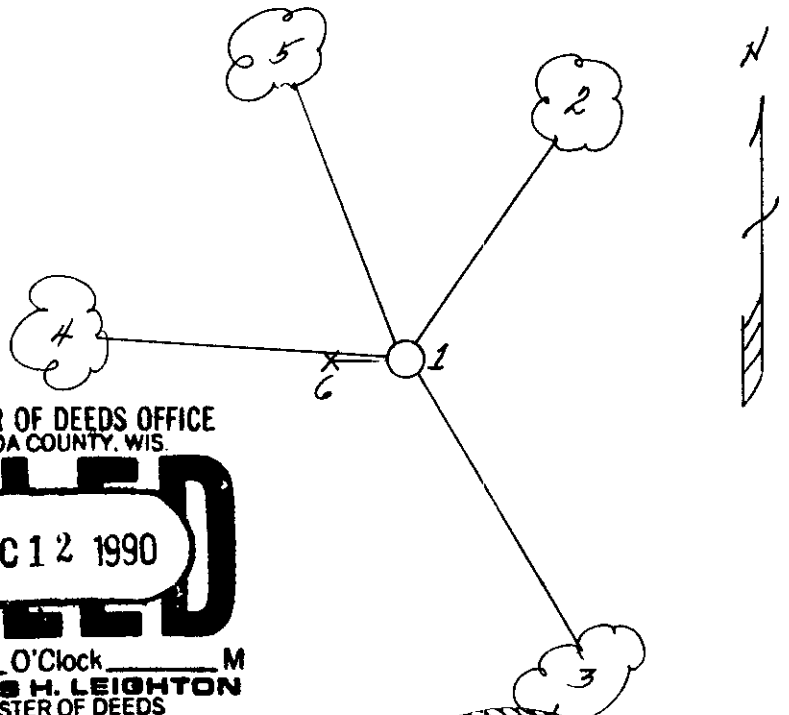

REGISTER OF DEEDS OFFICE
 ONEIDA COUNTY, WIS.
FILED
 DEC 12 1990
 At _____ O'Clock _____ M
 THOMAS H. LEIGHTON
 REGISTER OF DEEDS

WISCONSIN
 MILO E. STEFAN
 S-1558
 RHINELANDER, WIS.
 LAND SURVEYOR

(i) I, Milo E. Stefan
 (type or print name) certify that the corner location on this record was determined by me or under my direction and control and that this U.S. Public Land Survey Monument Record is correct and complete to the best of my knowledge and belief.

Milo E. Stefan
 Signature

12/5/90
 Date

3607150000
 Stamp

Index No. N-17