

U.S. PUBLIC LAND SURVEY MONUMENT RECORD


Note: This form is intended and designed to fulfill all requirements of Wisconsin Administrative Code, Chapter A-E 7.08 U.S. Public Land Survey Monument Record (3) (a) (b) (c) (d) (e) (f) (g) (h) (i). An additional sheet may be added if necessary to conform with said requirements.

(a) Corner location: Township 36 North

Range 7 East/West

Town/City/Village Woodboro

County Oneida

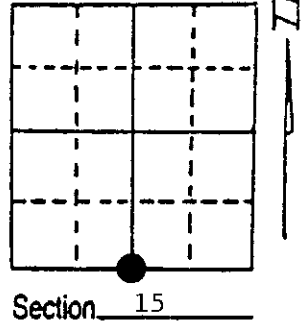

(b) (f) (g) (h) Description of monument found at this corner and if it was accepted, state all evidence (material, testimonial, occupational, plats, records, other monuments) used as a basis for accepting. If not accepted or if nothing was found, state evidence used as basis for establishing location. If reestablished through lost corner proportionate methods, indicate all monuments, distances and directions used to establish. Indicate type of monument found or set and sign post.

November 1862 - Joseph Jenkins established this corner and set a wood post with two BTs:
 10" Pine, N12°E, 14 Links 10" Aspen, S15°W, 30 Links


8/31/1937 - Maine found stump of original pine BT, tipped out, marks plain and restored corner by placement of a 2 1/4" x 60" iron pipe/brass cap and made one new BT - a 7" W. Pine, S61°E, 33.3 links.

12/9/1989 - Milo E. Stefan found Maine's monument in good condition and made four new BTs and set a plastic sign post.

(c) (d) (e) Plan view of corner with ties to at least 4 witness monuments. If in disagreement with previously established corner, show the distances between the two corners and also indicate the ties to the disputed corner.

- 1) 2 1/4" x 60" iron pipe with brass cap
- 2) 4" Red Maple, N15°E, 13.12'
- 3) 4" Red Maple, S10°E, 8.67'
- 4) 6" White Birch, S28°W, 41.30'
- 5) 8" Red Oak (Clump of 3 stems)
N32°W, 36.35'
- 6) Plastic sign post, northwest, 1.2'

Distances to nail in side of BTs
 Stump blazes scribed "BT"

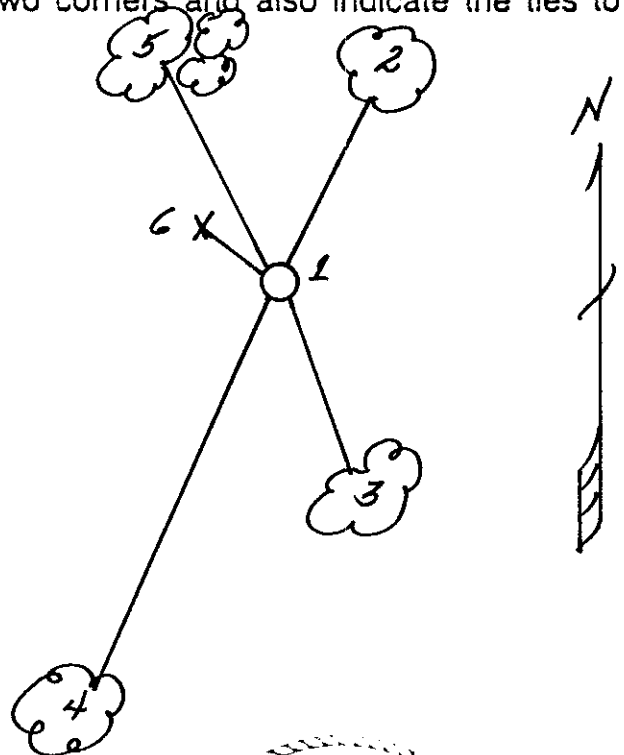

(i) I, Milo E. Stefan
 (type or print name) certify that the corner location on this record was determined by me or under my direction and control and that this U.S. Public Land Survey Monument Record is correct and complete to the best of my knowledge and belief.

Milo E. Stefan
 Signature

12/9/89
 Date



Index No. N-15

3607150020