


U.S. PUBLIC LAND SURVEY MONUMENT RECORD

Note: This form is intended and designed to fulfill all requirements of Wisconsin Administrative Code, Chapter A-E 7.08 U.S. Public Land Survey Monument Record (3) (a) (b) (c) (d) (e) (f) (g) (h) (i). An additional sheet may be added if necessary to conform with said requirements.

(a) Corner location: Township 36 North
 Range 7 East/West
 Town/City/Village Woodboro
 County Oneida

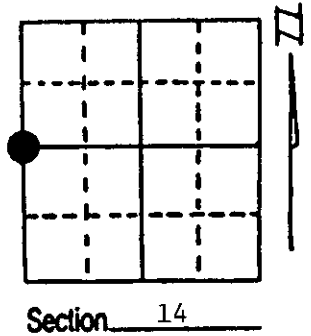

(b) (f) (g) (h) Description of monument found at this corner and if it was accepted, state all evidence (material, testimonial, occupational, plats, records, other monuments) used as a basis for accepting. If not accepted or if nothing was found, state evidence used as basis for establishing location. If reestablished through lost corner proportionate methods, indicate all monuments, distances and directions used to establish. Indicate type of monument found or set and sign post.


Nov. 1862 - Joseph H. Jenkins established this corner at 40.00 chains and set a wood post with two BTs:
 6" Spruce, N37°W, 13 Links (8.58') 7" Spruce, S38°E, 33 Links (21.78')

Sept. 3, 1937 - Vern Maine found original post with stump of 7" Spruce, S38°E, 33 Links, scribed; other stump nearly gone. He placed a 2" x 60" iron pipe and one reference, a 14" Tamarack Stump, N24°E, 25 Links (16.5').

Aug. 29, 1995 - Milo E. Stefan found Maine's monument in good condition. We set two reference monuments, as no bearing trees were near.

(c) (d) (e) Plan view of corner with ties to at least 4 witness monuments. If in disagreement with previously established corner, show the distances between the two corners and also indicate the ties to the disputed corner.

- 1) 2" x 60" Iron pipe with brass cap.
 - 2) Plastic sign post, North, 1.0'.
 - 3) 2" x 30" aluminum monument (R.M. 2):
 - a) 8" Aspen, S32°E, 22.14'
 - b) 8" Aspen, S33°W, 45.03'
 - c) 6" Aspen, S52°W, 45.84'
 - d) 1/4 Corner, N35°E, 308.22'
 - e) R.M. 1, N35°E, 64.90'
 - f) Plastic sign post, South, .8'
 - 4) 2" x 30" Aluminum monument (R.M. 1):
 - a) 8" Spruce, N83°E, 30.39'
 - b) 8" Spruce, N79°W, 37.99'
- BT Tags on each bearing tree.
 Distances to nail in side of BTs.
 Stump blaze scribed "BT".

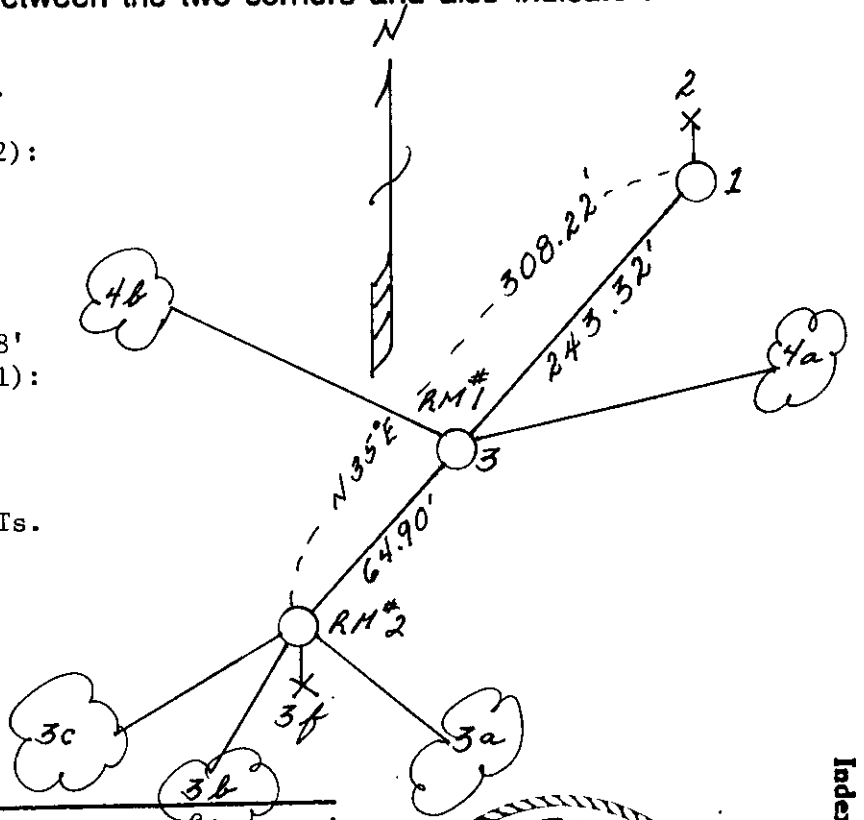

(i) I, Milo E. Stefan
 (type or print name) certify that the corner location on this record was determined by me or under my direction and control and that this U.S. Public Land Survey Monument Record is correct and complete to the best of my knowledge and belief.

Milo E. Stefan Signature September 11, 1995 Date



Index No. I-17

3607152000