


# U.S. PUBLIC LAND SURVEY MONUMENT RECORD

Note: This form is intended and designed to fulfill all requirements of Wisconsin Administrative Code, Chapter A-E 5.02, U.S. Public Land Survey Monument Record (3) (a) (b) (c) (d) (e) (f) (g) (h) (i). An additional sheet may be added if necessary to conform with said requirements.

(a) Corner location: Township 36 North  
Range 7 East/West

Town/City/Village Woodboro

County Oneida

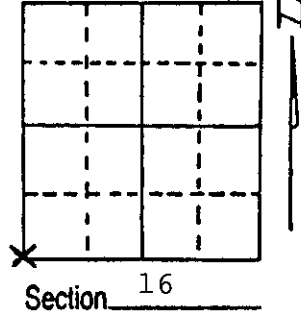

(b) (f) (g) (h) Description of monument found at this corner and if it was accepted, state all evidence (material, testimonial, occupational, plats, records, other monuments) used as a basis for accepting. If not accepted or if nothing was found, state evidence used as basis for establishing location. If reestablished through lost corner proportionate methods, indicate all monuments, distances and directions used to establish.

November 1862 by Joseph H. Jenkins at 80.00 chains set post for section corner:


- 10" Birch, N78°E, 23 links (15.18').
- 9" Aspen, S75°E, 23 links (15.18').
- 8" Aspen, S62°W, 9 links (5.94').
- 12" Aspen, N58°W, 13 links (8.58').

August 10, 1937; Maine found stumps of NE and SE original BTs and set county monument. No BTs near.

November 23, 1987; Milo E. Stefan found Maine county monument and made new BTs.

(c) (d) (e) Plan view of corner with ties to at least 4 witness monuments. If in disagreement with previously established corner, show the distances between the two corners and also indicate the ties to the disputed corner.

- 1. 6" White Birch, N63°E, 14.68'.
- \*2. 4" Red Maple, S64°E, 13.69'.
- 3. 10" Red Oak, S48°W, 80.64'.
- 4. 8" Red Oak, N60°W, 13.63'.
- 5. Plastic sign post, SW, 1.2'.  
BTs scribed "T36N R7E S(section) BT".  
\*Scribed "X BT".  
Distances to nail in side of tree.
- 6. 2" x 36" galv. iron pipe with brass cap.

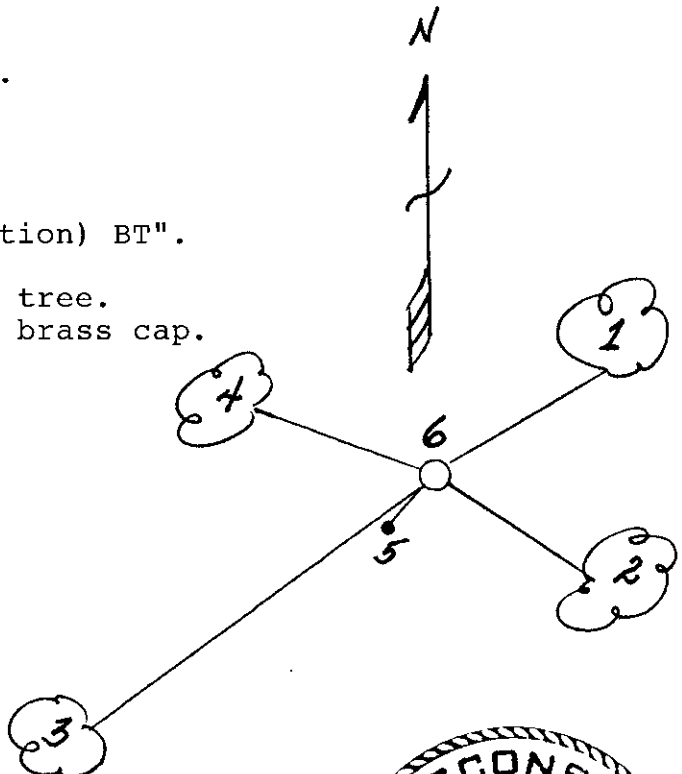

(i) I, Milo E. Stefan  
(type or print name) certify that the corner location on this record was determined by me or under my direction and control and that this U.S. Public Land Survey Monument Record is correct and complete to the best of my knowledge and belief.

Milo E. Stefan 12/6/87  
Signature Date



Index No. N-9

36070000