


# U.S. PUBLIC LAND SURVEY MONUMENT RECORD

**Note:** This form is intended and designed to fulfill all requirements of Wisconsin Administrative Code, Chapter A-E 7.08 U.S. Public Land Survey Monument Record (3) (a) (b) (c) (d) (e) (f) (g) (h) (i). An additional sheet may be added if necessary to conform with said requirements.

(a) Corner location: Township 36 North  
 Range 7 East/West

Town/City/Village Woodboro  
 County Oneida

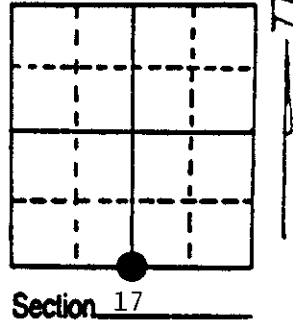


(b) (f) (g) (h) Description of monument found at this corner and if it was accepted, state all evidence (material, testimonial, occupational, plats, records, other monuments) used as a basis for accepting. If not accepted or if nothing was found, state evidence used as basis for establishing location. If reestablished through lost corner proportionate methods, indicate all monuments, distances and directions used to establish. Indicate type of monument found or set and sign post.

- 11/1862 - Joseph H. Jenkins established this corner and set a wood post with two BTs:  
 10" Black Pine, N61°E, 20 Links      10" Black Pine, S83°W, 12 Links
- 9/6/1937 - Maine restored corner by Lost Methods and set a 2" x 60" iron pipe with brass cap and one reference:      9" White Pine Stump, S56°W, 15.8 Links
- 3/1/1990 - Milo E. Stefan found Maine's monument in good condition and made new BTs and set plastic sign post.

(c) (d) (e) Plan view of corner with ties to at least 4 witness monuments. If in disagreement with previously established corner, show the distances between the two corners and also indicate the ties to the disputed corner.

- 1) 2" x 60" Iron pipe with brass cap
- 2) 11" Red Pine, N22°E, 51.97'
- 3) 16" White Pine, N75°E, 54.66'
- 4) 16" Red Pine, S67°E, 32.52'
- 5) 22" Red Pine, S10°W, 20.90'
- 6) Plastic sign post, East, 1.0'

Distances to nail in side of BT  
 BTs scribed "BT" in stump blaze

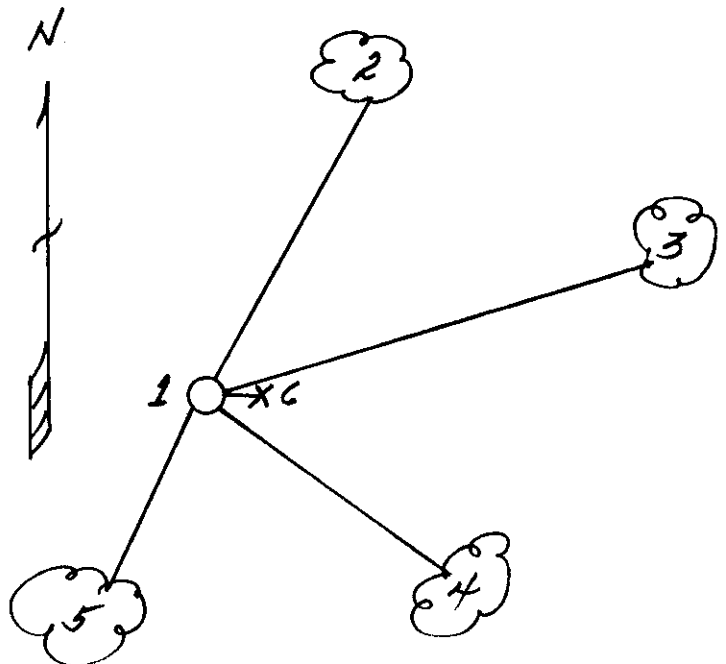

(i) I, Milo E. Stefan  
 (type or print name) certify that the corner location on this record was determined by me or under my direction and control and that this U.S. Public Land Survey Monument Record is correct and complete to the best of my knowledge and belief.

Milo E. Stefan      3/1/90  
 Signature      Date



Index No. N-7

3607170020  
 Stamp