


U.S. PUBLIC LAND SURVEY MONUMENT RECORD

Note: This form is intended and designed to fulfill all requirements of Wisconsin Administrative Code, Chapter A-E 5.02, U.S. Public Land Survey Monument Record (3) (a) (b) (c) (d) (e) (f) (g) (h) (i). An additional sheet may be added if necessary to conform with said requirements.

(a) Corner location: Township 36 North
 Range 7 East/West

Town/City/Village = Woodboro

County Oneida

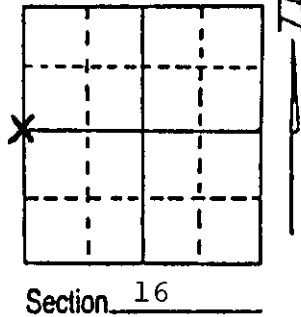


(b) (f) (g) (h) Description of monument found at this corner and if it was accepted, state all evidence (material, testimonial, occupational, plats, records, other monuments) used as a basis for accepting. If not accepted or if nothing was found, state evidence used as basis for establishing location. If reestablished through lost corner proportionate methods, indicate all monuments, distances and directions used to establish.

November 1862; Joseph H. Jenkins at 40.00 chains set 1/4 section post:
 12" White Pine, N25°E, 25 links (16.50').
 6" Red Pine, S38°W, 20 links (13.20').
 August 12, 1937; Maine found point of old stake and 12" Red Pine
 N46°E, 25 links, BT scribing plain. Maine thought this to be the
 original BT and set county monument.
 December 1, 1987; Milo E. Stefan found Maine's corner and cut new Bt's
 and placed sign post:
 North-South fence bears Easterly 115'.
 Pine stump N46°E, 25 links very decayed.

(c) (d) (e) Plan view of corner with ties to at least 4 witness monuments. If in disagreement with previously established corner, show the distances between the two corners and also indicate the ties to the disputed corner.

1. 2" x 36" galv. iron pipe with brass cap.
2. 6" Red Oak, N77°E, 35.70'.
3. 10" Jack Pine, S65°E, 98.07'.
4. 16" White Pine, S71°W, 105.48'.
5. 26" White Spruce, N29°W, 97.45'.
6. Plastic sign post, SW, 1.2'.
7. Original Pine stump, N46°E, 16.5'.
 BTs - scribed "1/4S BT".
 Distances measured from nail in side of BTs.

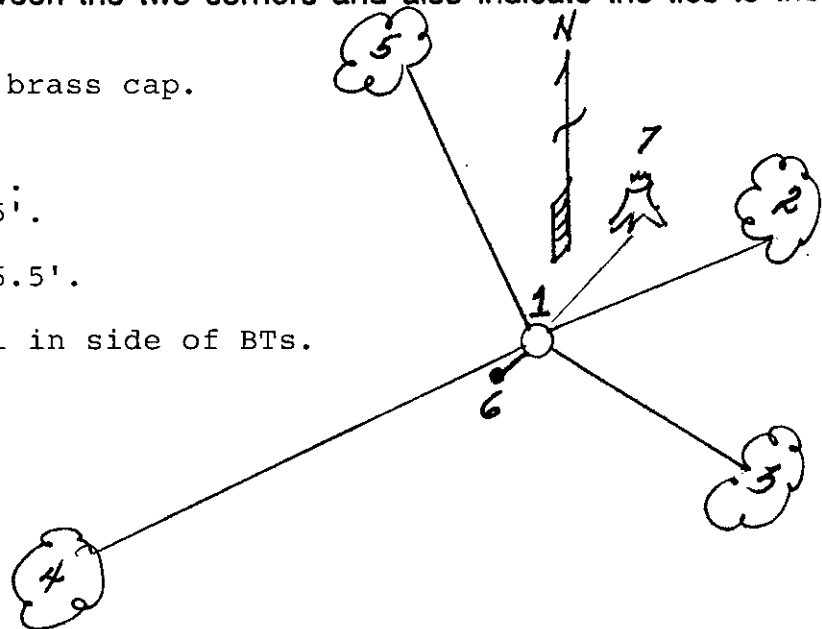

(i) I, Milo E. Stefan
 (type or print name) certify that the corner location on this record was determined by me or under my direction and control and that this U.S. Public Land Survey Monument Record is correct and complete to the best of my knowledge and belief.

Milo E. Stefan 12/6/87
 Signature Date



Index No. 7-9

3607172000