


U.S. PUBLIC LAND SURVEY MONUMENT RECORD

Note: This form is intended and designed to fulfill all requirements of Wisconsin Administrative Code, Chapter A-E 7.08 U.S. Public Land Survey Monument Record (3) (a) (b) (c) (d) (e) (f) (g) (h) (i). An additional sheet may be added if necessary to conform with said requirements.

(a) Corner location: Township 36 North
 Range 7 East/West

Town/City/Village Woodboro

County Oneida

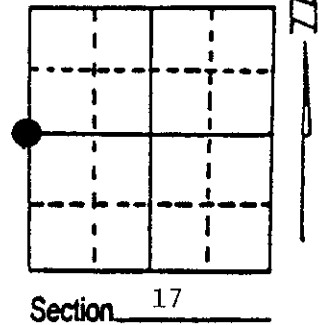

Section 17

(b) (f) (g) (h) Description of monument found at this corner and if it was accepted, state all evidence (material, testimonial, occupational, plats, records, other monuments) used as a basis for accepting. If not accepted or if nothing was found, state evidence used as basis for establishing location. If reestablished through lost corner proportionate methods, indicate all monuments, distances and directions used to establish. Indicate type of monument found or set and sign post.

11/1862 - Joseph H. Jenkins established this corner and set a wood post with two BTs:
 7" White Pine, N36°E, 20 Links 16" Y. Pine, S46°W, 15 Links


8/13/1937 - Maine found stake from stumps of original BTs. Marks plain on Yellow Pine;
 set a 2" x 60" iron pipe/brass cap.

2/23/1990 - Milo E. Stefan found Maine's monument in good condition with Yellow Pine
 stump still there with parts of scribing visible, S46°W, 10.6' to face.
 We made new BTs and set plastic sign post.

(c) (d) (e) Plan view of corner with ties to at least 4 witness monuments. If in disagreement with previously established corner, show the distances between the two corners and also indicate the ties to the disputed corner.

- 1) 2" x 60" iron pipe with brass cap
- 2) 8" Red Maple, N8°E, 22.56'
- 3) 6" Red Maple, S68°E, 14.11'
- 4) 8" Red Maple, S8°W, 36.89'
- 5) 16" Red Pine Stump, S46°W, 10.6' (Orig.)
- 6) 8" White Birch, N74°W, 24.16'
- 7) Plastic sign post, NE, 1.0'

Distances to nail in side of BTs.
 BTs scribed "BT" in stump blaze.

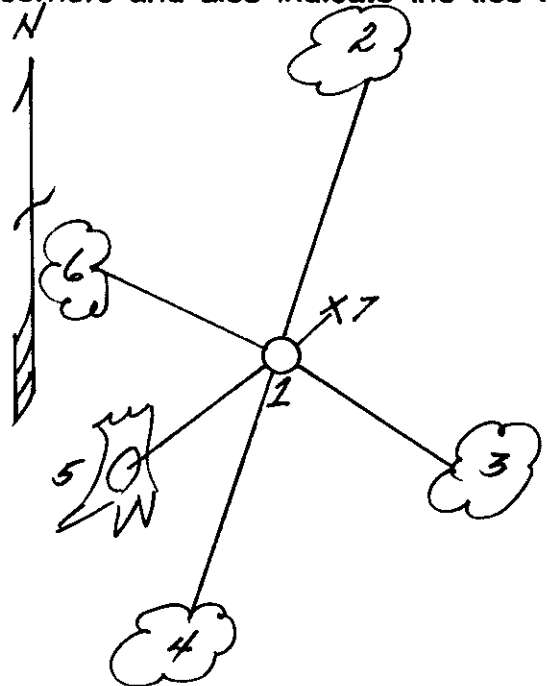

(i) I, Milo E. Stefan
 (type or print name) certify that the corner location on this record was determined by me or under my direction and control and that this U.S. Public Land Survey Monument Record is correct and complete to the best of my knowledge and belief.

Milo E. Stefan 2/26/90
 Signature Date



3607182000
 Stamp

Index No. L-5