


# U.S. PUBLIC LAND SURVEY MONUMENT RECORD

Note: This form is intended and designed to fulfill all requirements of Wisconsin Administrative Code, Chapter A-E 7.08 U.S. Public Land Survey Monument Record (3) (a) (b) (c) (d) (e) (f) (g) (h) (i). An additional sheet may be added if necessary to conform with said requirements.

(a) Corner location: Township 36 North  
 Range 7 East/West

Town/City/Village Woodboro

County Oneida

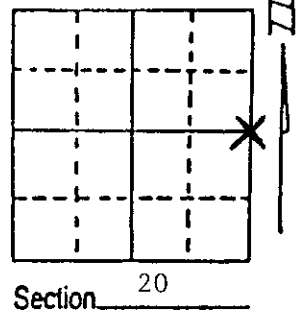

(b) (f) (g) (h) Description of monument found at this corner and if it was accepted, state all evidence (material, testimonial, occupational, plats, records, other monuments) used as a basis for accepting. If not accepted or if nothing was found, state evidence used as basis for establishing location. If re-established through lost corner proportionate methods, indicate all monuments, distances and directions used to establish. Indicate type of monument found or set and sign post.

1862 - Joseph H. Jenkins set a wood post for 1/4 corner at 40.00 chains:  
 10" W. Pine, N25°W, 42 links                      12" Aspen, S80°E, 6 links


8/10/1937 - Maine found evidence of B.F. Door's restoration of this corner and set a county monument. Dorr's BTs:  
 10" Pine Stump, S8 1/2°W, 37 links                      24 Pine Stump, N4°W, 25 1/2 links

2/25/89 - Milo E. Stefan found county monument as set by Maine, a 2" x 60" galvanized iron pipe with brass cap. I made new BTs and set sign post.

(c) (d) (e) Plan view of corner with ties to at least 4 witness monuments. If in disagreement with previously established corner, show the distances between the two corners and also indicate the ties to the disputed corner.

1. 2" x 60" galvanized iron pipe/brass cap
2. 2" Red Maple, N54°E, 34.08'
3. 8" Red Maple, S42°E, 12.96'
4. 4" Red Maple, S35°W, 20.96'
5. 8" Aspen, N49°W, 35.60'
6. Plastic sign post, West 1.5'

Distances to nail in side of tree.  
 All BTs scribed in stump blaze "BT"

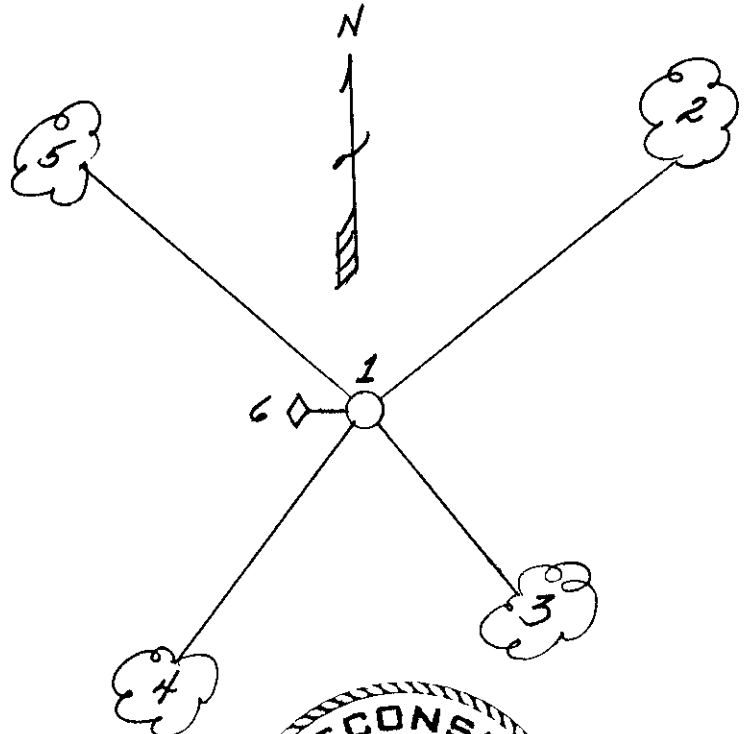

(i) I, Milo E. Stefan  
 (type or print name) certify that the corner location on this record was determined by me or under my direction and control and that this U.S. Public Land Survey Monument Record is correct and complete to the best of my knowledge and belief.



Index No. P-9

Milo E. Stefan  
 Signature

March 10, 1989  
 Date

3607202000