

Stock No. 26273


U. S. PUBLIC LAND SURVEY MONUMENT RECORD

INSTRUCTIONS: This record shall show the location of the corner and shall include all of the following nine elements (a through i).

(a) Identify the corner by reference to the U.S. public land survey system.

Compared with all record data and accepted as correct.

Robert H. Vernal 12/14/84
 Oneida County Surveyor date

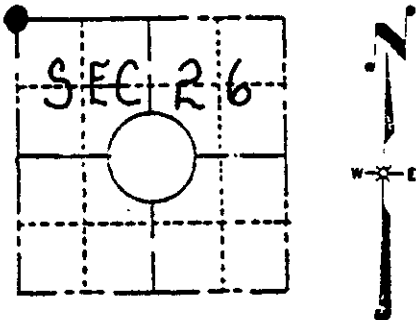

LOCATION SKETCH
 (Location of landmark indicated by "⊙")


The Section Corner of Sections 22, 23, 26, 27
 T 36N, R7E
 4th Principle Meridian

(b) Describe any record evidence, monument evidence, occupational evidences, testimonial evidence or any other material evidence you considered, and whether the monument was found or placed.

Original corner was set by Jenkins in 1862. Vaughn recovered the corner on October 13, 1905. Maines recovered the corner July 2nd 1937. He set an official corner. I recovered the official corner (in swamp, no bearing trees). I set new bearing trees.

(c) In the plan view drawing below, provide reference ties to at least 4 witness monuments, or, if the location is within a municipality, to at least 2 witness monuments. (Witness monuments shall be made of concrete, natural stone, iron or other equally durable material, except wood.) Describe witness monuments.

(d) Show a plan view drawing depicting the relevant monuments and reference ties which is sufficient in detail to enable accurate relocation of the corner monument if the corner monument is disturbed. Indicate north.

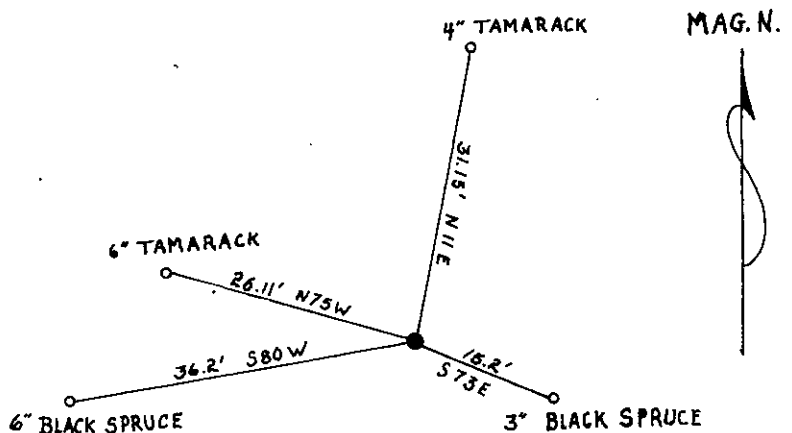

● SECTION CORNER

R-17

3607220000

(e) Describe any material discrepancy between the location of the corner as restored or reestablished and the location of that corner as previously restored or reestablished by distance and direction. Show the discrepancy on the plan view drawing under (d), above. Show the distances between the corner as previously restored or reestablished and (1) the corner as restored or reestablished, and (2) to at least 2 of the witness monuments shown on the drawing in (d), above.

(f) Was the corner restored through acceptance of (1) an obliterated evidence location, or, (2) a found perpetuated location?

The corner bearing trees were restored through use of a found perpetuated location as described on the reverse side of this form.

(g&h) Was the corner reestablished through lost corner proportionate methods? If so, show the method, including the directions and distances to other public land survey corners used as evidence or used for proportioning in determining the corner location?

REGISTER'S OFFICE }
Oncida County, Wis. }

Received for Record the 18th day of
January A.D. 1984 at
10:00 o'clock A.M. and recorded in
Vol. _____ on page _____
Louis George Kuehn
Register

(1) I, PAUL W. MARKWORTH
(type or print name) certify that the corner location shown
on this record was determined by me or under my direction and
control and that this U.S. Public Land Survey Monument Record
is correct and complete to the best of my knowledge and belief.

Paul W. Markworth
Signature

Date

