


U.S. PUBLIC LAND SURVEY MONUMENT RECORD

Note: This form is intended and designed to fulfill all requirements of Wisconsin Administrative Code, Chapter A-E 7.08 U.S. Public Land Survey Monument Record (3) (a) (b) (c) (d) (e) (f) (g) (h) (i). An additional sheet may be added if necessary to conform with said requirements.

(a) Corner location: Township 36 North
 Range 7 East/West

Town/City/Village Woodboro

County Oneida

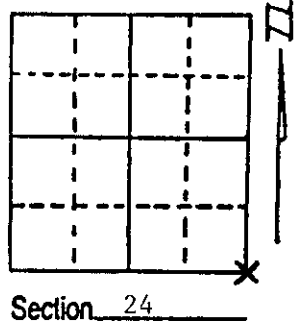

(b) (f) (g) (h) Description of monument found at this corner and if it was accepted, state all evidence (material, testimonial, occupational, plats, records, other monuments) used as a basis for accepting. If not accepted or if nothing was found, state evidence used as basis for establishing location. If reestablished through lost corner proportionate methods, indicate all monuments, distances and directions used to establish. Indicate type of monument found or set and sign post.

9/2/1860 - By Alfred Millard at 80.00 chains set wood post and BTs:
 10" White Pine, N73°E, 10 links 10" White Pine, S63°E, 46 links
 20" White Pine, S59°W, 42 links 16" White Pine, N57°W, 18 links

8/10/1942 - Norville Shearer from G.L.O. on an dependent resurvey and extension survey of Section 19, 36-8 found remains of all four original BTs and set a 6" x 24" concrete monument with brass cap and new BTs:
 9" Aspen, N53½°E, 15 links 11" Aspen, S67 3/4°E, 41 links
 7" Maple, S29½°W, 50 links 12" Red Oak, N55 3/4°W, 55 links


1/14/89 - Milo E. Stefan found G.L.O. monument in good condition with only the Oak BT remaining (N56°W, 36.23'). I made three new BTs and set sign post.

(c) (d) (e) Plan view of corner with ties to at least 4 witness monuments. If in disagreement with previously established corner, show the distances between the two corners and also indicate the ties to the disputed corner.

1. 6" x 24" G.L.O. Brass Capped Monument
2. 4" Red Oak, N35°E, 24.45'
3. 12" Red Oak, S14°W, 45.50'
4. 6" Red Maple, S82°W, 41.58'
5. 18" Red Oak, N56°W, 36.23'
6. Plastic Sign Post next to monument
7. Plastic lot corner post to lots 11/12

Distances to nail in side of trees.

Trees scribed "BT" in stump blaze.

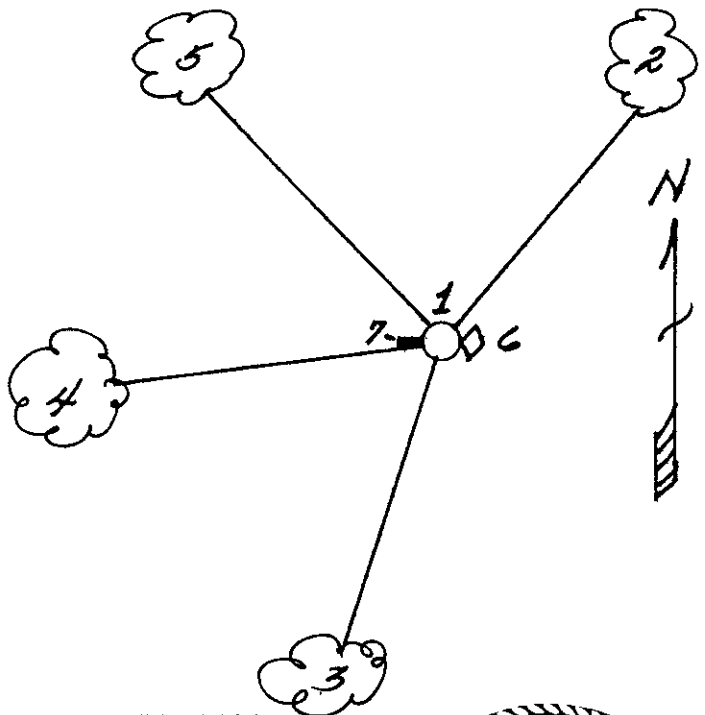

(i) I, Milo E. Stefan
 (type or print name) certify that the corner location on this record was determined by me or under my direction and control and that this U.S. Public Land Survey Monument Record is correct and complete to the best of my knowledge and belief.

Milo E. Stefan
 Signature

2/16/89
 Date



Index No. R-25

3607240000