

# U.S. PUBLIC LAND SURVEY MONUMENT RECORD


**Note:** This form is intended and designed to fulfill all requirements of Wisconsin Administrative Code, Chapter A-E 7.08 U.S. Public Land Survey Monument Record (3) (a) (b) (c) (d) (e) (f) (g) (h) (i). An additional sheet may be added if necessary to conform with said requirements.

(a) Corner location: Township 36 North

Range 7 East/West

Town/City/Village Woodboro

County Oneida

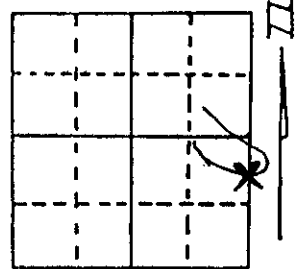

Section 24

(b) (f) (g) (h) Description of monument found at this corner and if it was accepted, state all evidence (material, testimonial, occupational, plats, records, other monuments) used as a basis for accepting. If not accepted or if nothing was found, state evidence used as basis for establishing location. If reestablished through lost corner proportionate methods, indicate all monuments, distances and directions used to establish. Indicate type of monument found or set and sign post.

9/2/1860 - Alfred Millard at 31.00 chains intersected lake and set wood post for Meander Corner:

9" White Birch, S16°E, 18 links                      10" Aspen, N65°W, 36 links

1942 - G.L.O. restored corner and set a 2" x 36" iron post with brass cap and two BTs:


11" Maple, S56 1/2°E, 40 links                      6" Maple, S57°W, 17 links

1/14/89 - Milo E. Stefan found G.L.O. monument in excellent condition and 10" Red Maple, S57°W, 10.80'. I made new BTs and set plastic sign post.

(c) (d) (e) Plan view of corner with ties to at least 4 witness monuments. If in disagreement with previously established corner, show the distances between the two corners and also indicate the ties to the disputed corner.

1. 2" x 36" G.L.O. brass capped monument
2. 4" Red Maple, S88°E, 24.71'
3. 6" Red Maple, S15°E, 15.81'
4. 10" Red Maple, S57°W, 10.80'
5. 14" Red Oak, S82°W, 26.01'
6. Plastic sign post

Distances to nail in side of BT  
BTs scribed in base "BT"

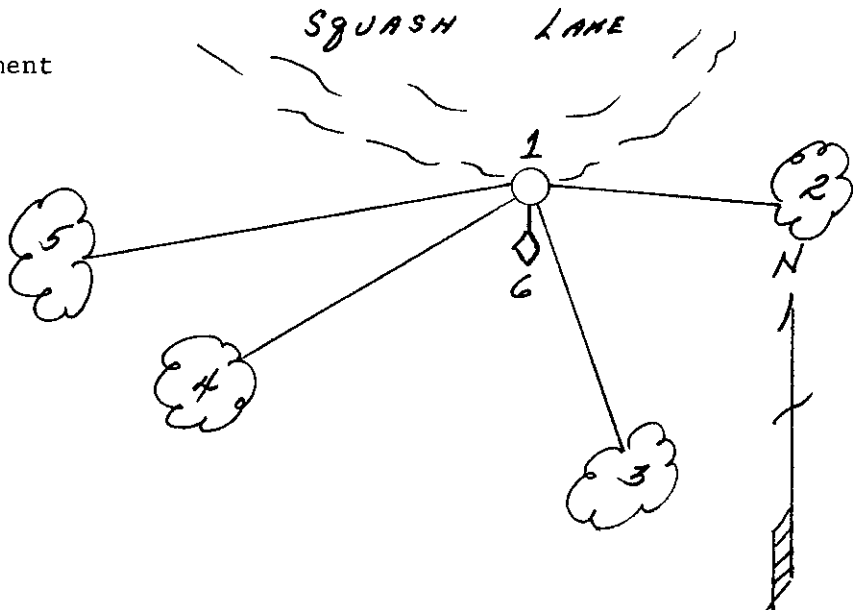

(i) I, Milo E. Stefan  
(type or print name) certify that the corner location on this record was determined by me or under my direction and control and that this U.S. Public Land Survey Monument Record is correct and complete to the best of my knowledge and belief.

Milo E. Stefan  
Signature

2/16/89  
Date



Index No. P.O. # South M.C. 35

3607241800