


U.S. PUBLIC LAND SURVEY MONUMENT RECORD

Note: This form is intended and designed to fulfill all requirements of Wisconsin Administrative Code, Chapter A-E 7.08 U.S. Public Land Survey Monument Record (3) (a) (b) (c) (d) (e) (f) (g) (h) (i). An additional sheet may be added if necessary to conform with said requirements.

(a) Corner location: Township 36 North
Range 8 East/West
Town/City/Village Crescent
County Oneida

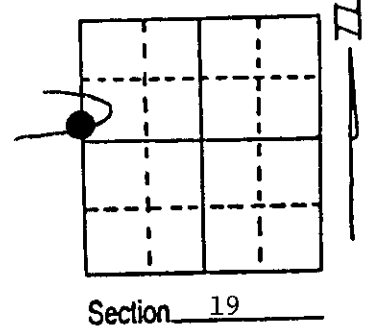

(b) (f) (g) (h) Description of monument found at this corner and if it was accepted, state all evidence (material, testimonial, occupational, plats, records, other monuments) used as a basis for accepting. If not accepted or if nothing was found, state evidence used as basis for establishing location. If reestablished through lost corner proportionate methods, indicate all monuments, distances and directions used to establish. Indicate type of monument found or set and sign post.

9/2/1860 - Alfred Millard made a 6" Tamarack on south shore for the Meander Corner. He made one BT: 6" Tamarack, N15°E, 16 Links


1942 - GLO restored corner at proportionate position and set an iron post with brass cap: 7" Tamarack, N34½°E, 55 Links 5" Tamarack, S11°W, 43 Links

7/28/89 - Milo E. Stefan found GLO Monument with NE BT a rotten stump. We made new BTs and set plastic sign post.

(c) (d) (e) Plan view of corner with ties to at least 4 witness monuments. If in disagreement with previously established corner, show the distances between the two corners and also indicate the ties to the disputed corner.

- 1) 1" x 36" GLO Monument
- 2) 8" Tamarack, N36°E, 64.83'
- 3) 5" Tamarack, N70°E, 30.32'
- 4) 6" Tamarack, S45°E, 57.18'
- 5) 6" Tamarack, S9°W, 6.15'
- 6) Plastic sign post, North, .6'

Distances to nail on side of BTs.
BTs scribed "BT" in stump blaze.

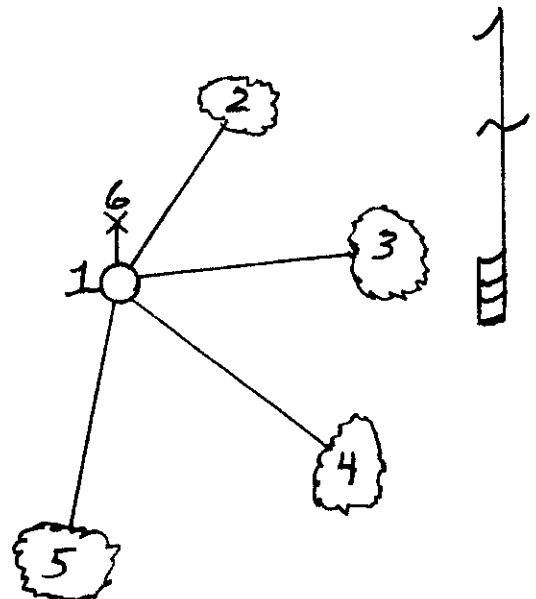

(i) I, Milo E. Stefan
(type or print name) certify that the corner location on this record was determined by me or under my direction and control and that this U.S. Public Land Survey Monument Record is correct and complete to the best of my knowledge and belief.

Milo E. Stefan 8/5/89
Signature Date



Index No. O.P. - 1

360724 2700