


U.S. PUBLIC LAND SURVEY MONUMENT RECORD

Note: This form is intended and designed to fulfill all requirements of Wisconsin Administrative Code, Chapter A-E 5.02, U.S. Public Land Survey Monument Record (3) (a) (b) (c) (d) (e) (f) (g) (h) (i). An additional sheet may be added if necessary to conform with said requirements.

(a) Corner location: Township 36 North
 Range 7 East ~~West~~

Town/~~City/Village~~ Woodboro

County Oneida

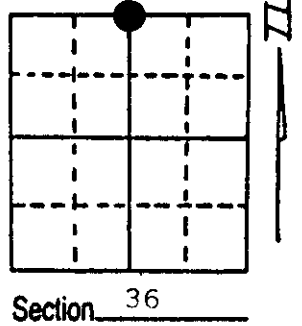

(b) (f) (g) (h) Description of monument found at this corner and if it was accepted, state all evidence (material, testimonial, occupational, plats, records, other monuments) used as a basis for accepting. If not accepted or if nothing was found, state evidence used as basis for establishing location. If reestablished through lost corner proportionate methods, indicate all monuments, distances and directions used to establish.

- 1863 Daugherty 40.3 ch. set Post Y. Pine 14" N 42 W 23 lks.
 W. Pine 8" S 65 E 16 lks.
- 1891 Dorr at corner
- 1978 J. Kreamer found nail at fence corner
- 1979 W. Immich set I.P. 64' off fence corner
- 1990 W.E. Badow set Oneida County Monument at fence corner and witnessed as shown below. W. Plastic Post W 1'. W. Immich set corner position N 83°10'W 64.27' of my corner position. No physical corner remains.


(c) (d) (e) Plan view of corner with ties to at least 4 witness monuments. If in disagreement with previously established corner, show the distances between the two corners and also indicate the ties to the disputed corner.

NOTE:

ALL MEASUREMENTS TAKEN FROM
 6" SPIKE IN SIDE OF TREE

BEARINGS TAKEN WITH
 HANDHELD MAGNETIC
 COMPASS

NO SCALE

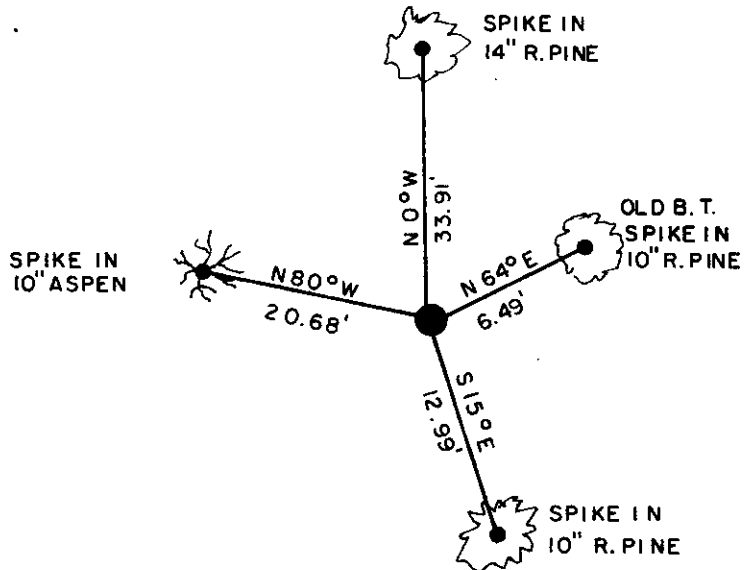

REGISTER OF DEEDS OFFICE
ONEIDA COUNTY, WIS

 At _____ O'Clock _____ M
THOMAS H. LEIGHTON
 REGISTER OF DEEDS

(i) I, William E. Badow
 (type or print name) certify that the corner location on this record was determined by me or under my direction and control and that this U.S. Public Land Survey Monument Record is correct and complete to the best of my knowledge and belief.

William E. Badow 2-1-91
 Signature Date



Index No. V-23

3607250020