


U.S. PUBLIC LAND SURVEY MONUMENT RECORD

Note: This form is intended and designed to fulfill all requirements of Wisconsin Administrative Code, Chapter A-E 7.08 U.S. Public Land Survey Monument Record (3) (a) (b) (c) (d) (e) (f) (g) (h) (i). An additional sheet may be added if necessary to conform with said requirements.

(a) Corner location: Township 36 North
 Range 7 East/West

Town/City/Village Woodboro

County Oneida

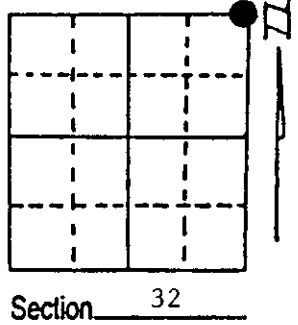

(b) (f) (g) (h) Description of monument found at this corner and if it was accepted, state all evidence (material, testimonial, occupational, plats, records, other monuments) used as a basis for accepting. If not accepted or if nothing was found, state evidence used as basis for establishing location. If reestablished through lost corner proportionate methods, indicate all monuments, distances and directions used to establish. Indicate type of monument found or set and sign post.

November 1862 - Joseph H. Jenkins established this corner and made four BTs:


- | | |
|------------------------------|------------------------------|
| 8" Tamarack, N74°E, 41 Links | 7" Tamarack, S34°W, 11 Links |
| 8" Tamarack, S81°E, 36 Links | 8" Tamarack, N60°W, 12 Links |

6/29/1937 - Maine found original BTs down, marks plain and set a Oneida County Monument.
 No BTs set.

7/25/1989 - Milo E. Stefan found Oneida County Monument in excellent condition. We made three new BTs and set plastic sign post.

(c) (d) (e) Plan view of corner with ties to at least 4 witness monuments. If in disagreement with previously established corner, show the distances between the two corners and also indicate the ties to the disputed corner.

- 1) 2" x 60" galvanized iron pipe/brass cap
- 2) 10" Tamarack, N63°E, 59.06'
- 3) 5" Black Spruce, N87°E, 65.62'
- 4) 6" Black Spruce, S66°E, 73.69'
- 5) Plastic sign post, North, .3'

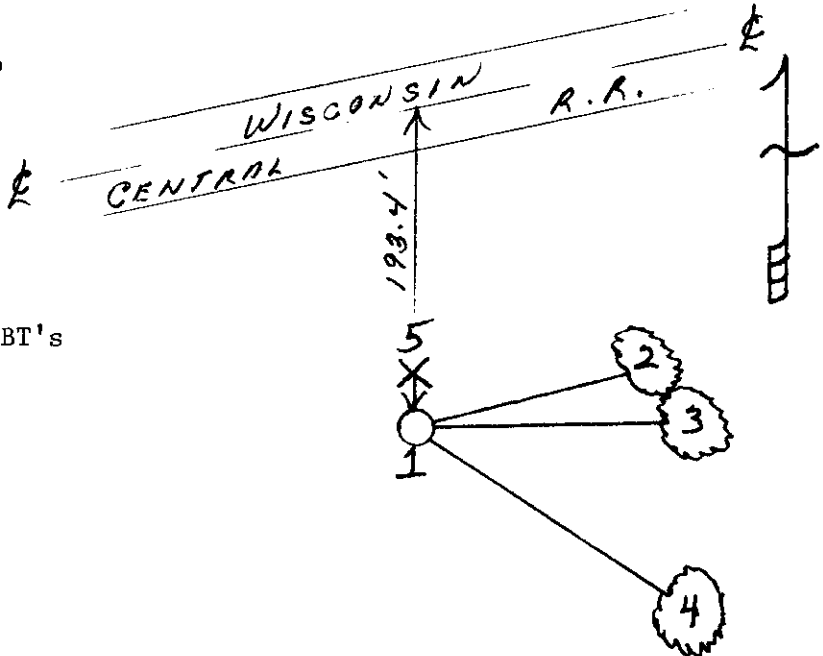

Distances to nail in side of BTs.
 BTs scribed "BT" in stump blaze.
 Corner is in dense tag alder swamp, no BT's available north, west and south.

(i) I, Milo E. Stefan
 (type or print name) certify that the corner location on this record was determined by me or under my direction and control and that this U.S. Public Land Survey Monument Record is correct and complete to the best of my knowledge and belief.

Milo E. Stefan
 Signature

8/5/89
 Date



Index No. A-6

3607290000