


# U.S. PUBLIC LAND SURVEY MONUMENT RECORD

Note: This form is intended and designed to fulfill all requirements of Wisconsin Administrative Code, Chapter A-E 7.08 U.S. Public Land Survey Monument Record (3) (a) (b) (c) (d) (e) (f) (g) (h) (i). An additional sheet may be added if necessary to conform with said requirements.

(a) Corner location: Township 36 North  
 Range 7 East/West  
 Town/City/Village Woodboro  
 County Oneida

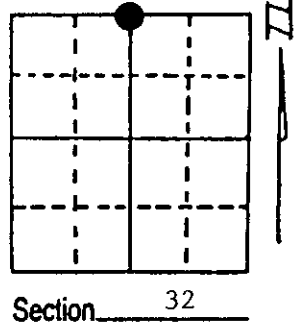

(b) (f) (g) (h) Description of monument found at this corner and if it was accepted, state all evidence (material, testimonial, occupational, plats, records, other monuments) used as a basis for accepting. If not accepted or if nothing was found, state evidence used as basis for establishing location. If reestablished through lost corner proportionate methods, indicate all monuments, distances and directions used to establish. Indicate type of monument found or set and sign post.

November 1862 - Joseph H. Jenkins established this corner and set a wood post and made two BTs:

10" Y. Pine, N15°E, 45 Links                      10" Y. Pine, S86°W, 24 Links

1900's - Vaughan was here and set Axel in road for corner.


6/28/1937 - Maine found Vaughan corner, BTs were gone. He placed a Witness Corner, 33 feet west with two BTs:

8" Y. Pine Stump, S84°W, 1.02 Chains    12" Y. Pine Stump, S57°W, 1.11 Chains

7/26/1989 - Milo E. Stefan found Witness Corner and axel 12" below road surface. BTs gone. We placed Oneida County Monument over axel and made new BTs.

(c) (d) (e) Plan view of corner with ties to at least 4 witness monuments. If in disagreement with previously established corner, show the distances between the two corners and also indicate the ties to the disputed corner.

- 1) 2" x 30" Aluminum Oneida County Monument with axel inside.
- 2) 6" Black Cherry, N53°E, 22.22'
- 3) 10" Red Pine, S62°W, 47.51'
- 4) 7" Red Pine, N89°W, 36.87'
- 5) 9" Red Pine, N38°W, 47.10'
- 6) Location post and plastic sign post west 32.3'
- 7) 2" x 60" B.C. Witness Corner west, 33.00'

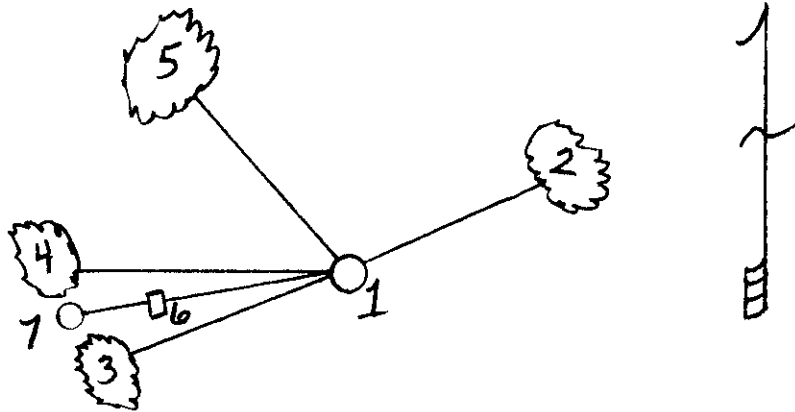

Distances to nail in side of BTs.  
 BTs scribed "BT" in stump blaze.

(i) I, Milo E. Stefan  
 (type or print name) certify that the corner location on this record was determined by me or under my direction and control and that this U.S. Public Land Survey Monument Record is correct and complete to the best of my knowledge and belief.

Milo E. Stefan                      8/5/89  
 Signature                                      Date



Index No. V-7

3607290020