U.S. PUBLIC LAND SURVEY MONUMENT RECORD

Note: This form is intended and designed to fulfill all requirements of Wisconsin Administrative Code, Chapter A-E 7.08 U.S. Public Land Survey Monument Record (3) (a) (b) (c) (d) (e) (f) (g) (h) (i). An additional sheet may be added if necessary to conform with said requirements.

(a) Corner location: Township 36 North

Range 7 East/~~West~~

~~Town/City/Village~~ Woodboro

County Oneida

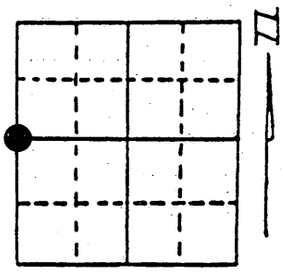

Section 28

(b) (f) (g) (h) Description of monument found at this corner and if it was accepted, state all evidence (material, testimonial, occupational, plats, records, other monuments) used as a basis for accepting. If not accepted or if nothing was found, state evidence used as basis for establishing location. If reestablished through lost corner proportionate methods, indicate all monuments, distances and directions used to establish. Indicate type of monument found or set and sign post.

11/1862 - Joseph H. Jenkins established this corner, set a wood post and 2 BTs:
10" Aspen, N27°W, 86 Links 8" Aspen, N42°E, 60 Links

9/7/1937 - Maine restored corner by Lost Methods and set a 2" x 60" iron pipe with flat brass cap along with two BTs:
10" Jack Pine, N10°E, .562 Chains 14" White Pine Stump, S49°E, .476 Chains

2/23/1990 - Milo E. Stefan found Maine's monument in good condition with White Pine Stump and Jack Pine still here. Made new BTs and placed plastic sign post.

(c) (d) (e) Plan view of corner with ties to at least 4 witness monuments. If in disagreement with previously established corner, show the distances between the two corners and also indicate the ties to the disputed corner.

1) 2" x 60" Iron pipe with brass cap.
2) 12" Jack Pine (dead), N10°E, 37.1' (Maines)
3) 5" Red Maple, S49°E, 25.41'
4) 14" White Pine (stump), S39°E, 31.4' (Maines)
5) 5" Red Maple, S66°W, 69.62'
6) 8" Red Maple, N55°W, 48.02'
7) Plastic sign post, SE, 1.2'

Distances to nail in side of BTs.
BTs scribed "BT" in stump blaze.

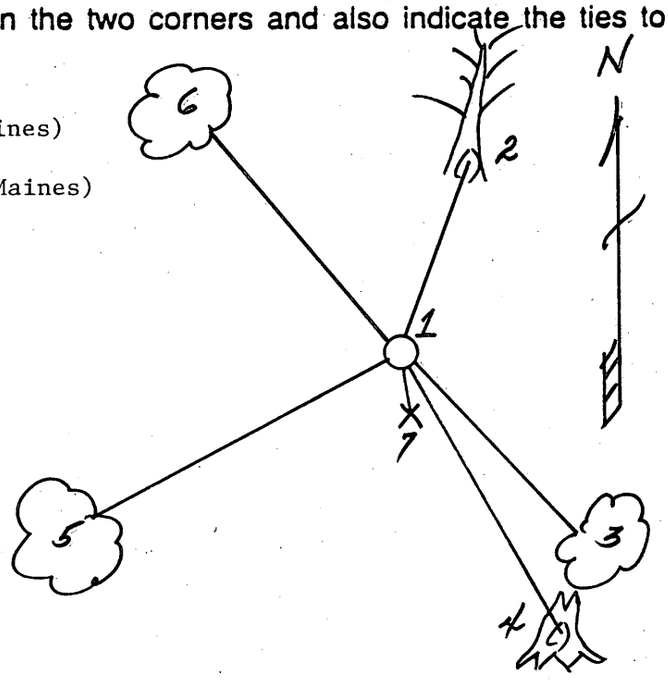

(i) I, Milo E. Stefan (type or print name) certify that the corner location on this record was determined by me or under my direction and control and that this U.S. Public Land Survey Monument Record is correct and complete to the best of my knowledge and belief.

Milo E. Stefan 2/26/90

Signature Date

WISCONSIN MILO E. STEFAN S-1558 RHINELANDER, WIS. LAND SURVEYOR

3607292000
Stamp

Index No. T-9