


U.S. PUBLIC LAND SURVEY MONUMENT RECORD

Note: This form is intended and designed to fulfill all requirements of Wisconsin Administrative Code, Chapter A-E 7.08 U.S. Public Land Survey Monument Record (3) (a) (b) (c) (d) (e) (f) (g) (h) (i). An additional sheet may be added if necessary to conform with said requirements.

(a) Corner location: Township 36 North
Range 7 East/West

Town/City/Village Woodboro

County Oneida

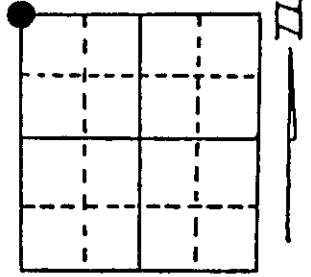

Section 32

(b) (f) (g) (h) Description of monument found at this corner and if it was accepted, state all evidence (material, testimonial, occupational, plats, records, other monuments) used as a basis for accepting. If not accepted or if nothing was found, state evidence used as basis for establishing location. If reestablished through lost corner proportionate methods, indicate all monuments, distances and directions used to establish. Indicate type of monument found or set and sign post.

November 1862 - Joseph H. Jenkins established this corner and a wood post with three BTs:
10" Black Pine, S76°E, 48 Links 10" W. Pine, S75°W, 36 Links
10" Black Pine, N64°W, 34 Links

1900 - Dorr restored corner and made new BT.


6/28/1937 - Maine found Dorr's BT cut off. He set Oneida County Monument below road surface and new BTs:
6" Jack Pine, N82°E, 49.4 Links 8" Jack Pine, N30°W, 105 Links

7/26/1989 - Milo E. Stefan found bottom of Oneida County Monument 18" below road surface and location poster post west, 14 1/2'. No trace of any BTs or BT remains. We placed a new Oneida County Monument 6" below road surface, made new BTs and set plastic sign post.

(c) (d) (e) Plan view of corner with ties to at least 4 witness monuments. If in disagreement with previously established corner, show the distances between the two corners and also indicate the ties to the disputed corner.

- 1) 2" iron pipe 18" below road surface and new 2" x 30" aluminum Oneida county monument 6" below road surface.
- 2) 12" Red Pine, S62°E, 59.60'
- 3) 20" Red Pine, S31°E, 54.21'
- 4) 6" Red Pine, S37°W, 63.77'
- 5) 8" Red Pine, S60°W, 40.70'
- 6) Plastic sign post along side location poster post, west, 14.2'

Distances to nail in side of BTs.
BTs scribed "BT" in stump blaze.

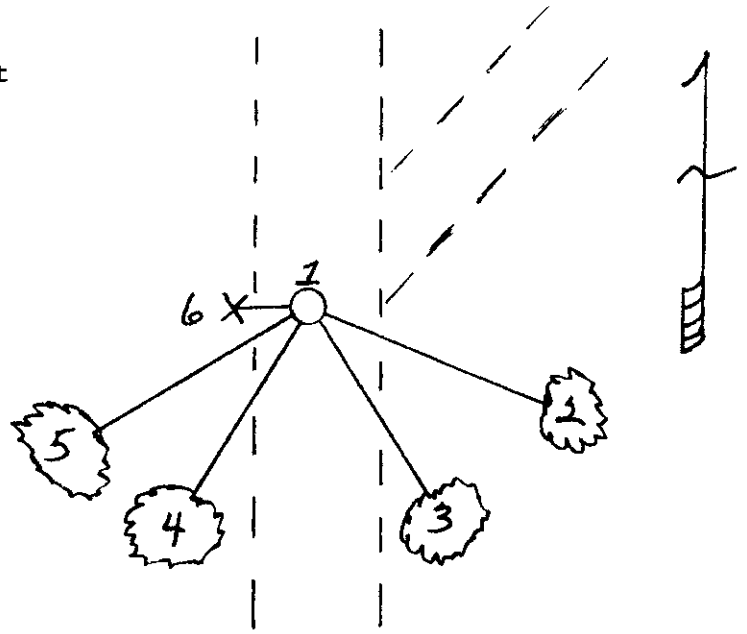

(i) I, Milo E. Stefan
(type or print name) certify that the corner location on this record was determined by me or under my direction and control and that this U.S. Public Land Survey Monument Record is correct and complete to the best of my knowledge and belief.

Milo E. Stefan
Signature

8/5/89
Date



Index No. V-5

3607300000