# U.S. PUBLIC LAND SURVEY MONUMENT RECORD

Note: This form is intended and designed to fulfill all requirements of Wisconsin Administrative Code, Chapter A-E 7.08 U.S Public Land Survey Monument Record (3) (a) (b) (c) (d) (e) (f) (g) (h) (i). An additional sheet may be added if necessary to conform with said requirements.

(a) Corner location: Township 36 North

Range 7 East/West

Town/City/Village Woodboro

County Oneida

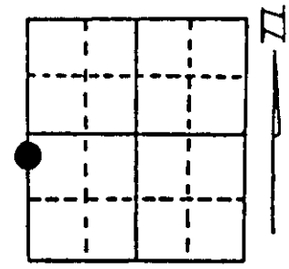

Section 29

(b) (f) (g) (h) Description of monument found at this corner and if it was accepted, state all evidence (material, testimonial, occupational, plats, records, other monuments) used as a basis for accepting. If not accepted or if nothing was found, state evidence used as basis for establishing location. If reestablished through lost corner proportionate methods, indicate all monuments, distances and directions used to establish. Indicate type of monument found or set and sign post.

11/1862 - Joseph H. Jenkins established this Meander Corner on the South Shore of a lake. He set a wood post with BTs:
9" Tamarack, S74°E, 7 Links (4.62') 6" Spruce, S40°W, 14 Links (9.24')

9/20/1937 - Vern Maine found original post point and stumps of both BTs. He set a 2" x 60" iron pipe/brass cap and two new BTs:
7" Jack Pine, S26°W, 42 Links (27.72')
3" Spruce, S20°W, 25.8 Links (17.03')

1960 & 1961 - Owens-Illinois used Maines monument to do work in Sections 29 & 30. Monument was in place when plat in the NW1/4SW1/4 of Section 29 was developed.

1/1989 - Milo E. Stefan found monument lying down and removed from proper position.

11/26/1996 - We restored Maines monument to its proper location. As determined from the Jack Pine Stump, S26°W, 27.72'. This position conforms to the plat distance of 503.45' Southerly and to the SMC (2" iron pipe), N70°40'W, 467.20'. We made four new BTs and set plastic sign post.

(c) (d) (e) Plan view of corner with ties to at least 4 witness monuments. If in disagreement with previously established corner, show the distances between the two corners and also indicate the ties to the disputed corner.

1) 2" x 60" Iron pipe/brass cap.
2) 5" Tamarack, S73°E, 37.80'.
3) 7" Black Spruce, S20°W, 5.95'.
4) 6" Black Spruce, N73°W, 34.59'.
5) 3" White Pine, N63°W, 36.80'.
6) Plastic Sign Post, South, 1.0'.

Distances to nail in side of BTs.
Stump blaze scribed "BT".
BT tags on face of BTs.

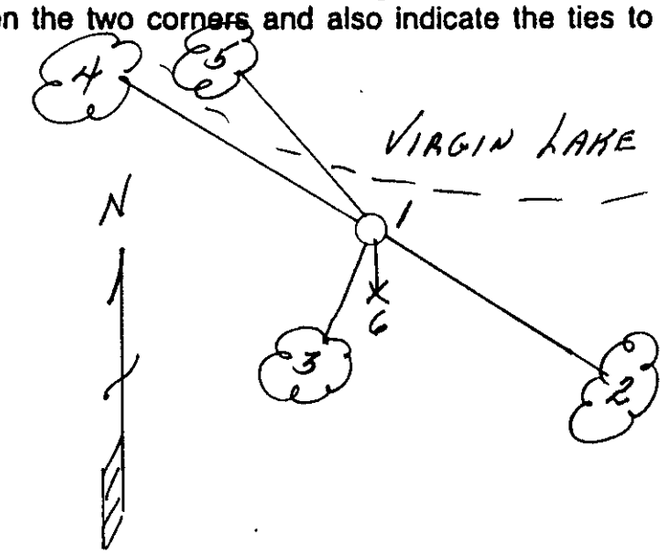


(i) I, Milo E. Stefan (type or print name) certify that the corner location on this record was determined by me or under my direction and control and that this U.S. Public Land Survey Monument Record is correct and complete to the best of my knowledge and belief.

Milo E Stefan — December 9, 1996

Signature — Date

WISCONSIN MILO E. STEFAN S-1558 RHINELANDER, WIS. LAND SURVEYOR

3607301700

Stamp

Index No. T, U - 5